

Woodson


KANSAS

SECTION 36 TOWNSHIP 26 RANGE 13 E

WELL NO. # 1 Tedlock

COMPANY Gus Bisango & Son

NORTH

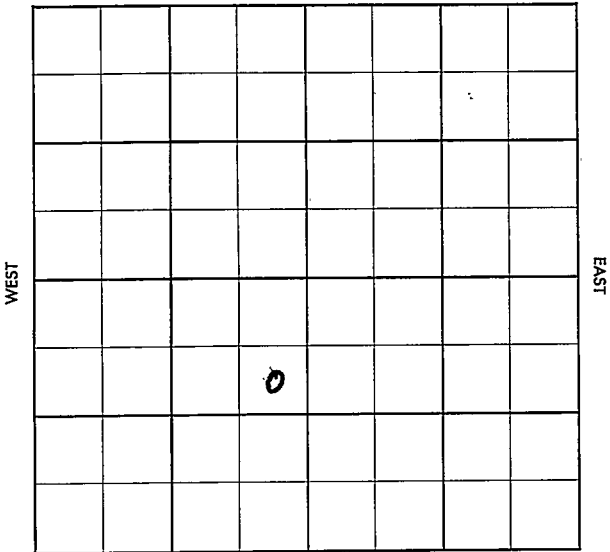

SOUTH

Woodson

KANSAS

SEC. 36	TWP. 26	R. <del>20E</del> 13E
------------	------------	--------------------------

WELL NO. #1 Tedlock FARM

COMPANY Gus Bisango & Son

CONTRACTOR Co. Tools


WILDCAT

\_\_\_\_\_ Ft. from N. Line

\_\_\_\_\_ Ft. from S. Line

\_\_\_\_\_ Ft. from E. Line

\_\_\_\_\_ Ft. from W. Line

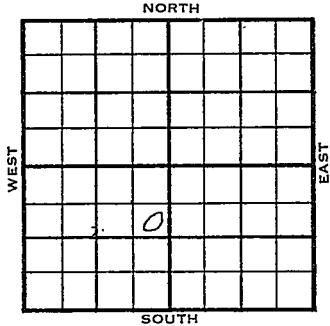

SE NE SW

1956	ELEVATION	REPORT
------	-----------	--------

4-11 SO 1078-98, 1152-57,  
 TD 1426  
 4" @ 1354  
 CO to 1374, 1 1/2 mcfg  
 D & A  
 Burbank 1353  
 M. 1403

FIRST REPORT  
*of*  
 ABANDONED

County Woodson Elev. \_\_\_\_\_  
 Sec. 36 Twp. 26 Rge. 13E  
 Company Gas Bisango & Son  
 Farm Name Tedlock No. 1

TOPS	DEPTH	LOG	DATUM	Loc. in Sec.
Anh.				SE NE SW
Tr.				
H.				
Tr.				
Dg.				
Bl.				
L.				Geol. _____
K.C.				Contr. _____
B.K.C.				
Ce.				
C. <u>Burbank</u>	<u>1353</u>			Co. tools
M.				
M.	<u>1103</u>			Pool
K.				<u>Wildcat</u>
Mz.				
Ma.				
V.				
S.				
S.				
A.				
R.				
PE.				
G.				
T.D.				

FIRST REPORT  
 APR 14 '56  
 ABANDONED

Date Comm. SO 1078-98 1152-57 TD 1126  
4" @ 1354 CO to 1374 1 1/2 mcfg

D & M  
 W. G. F.  
 1958

Co.  
 Sec.  
 T.  
 R.