


DX 78-1 Woodson

KANSAS

Section 26 Township 26 Range 13E

Well No. #1 La Rue

Company Geo R. Jones

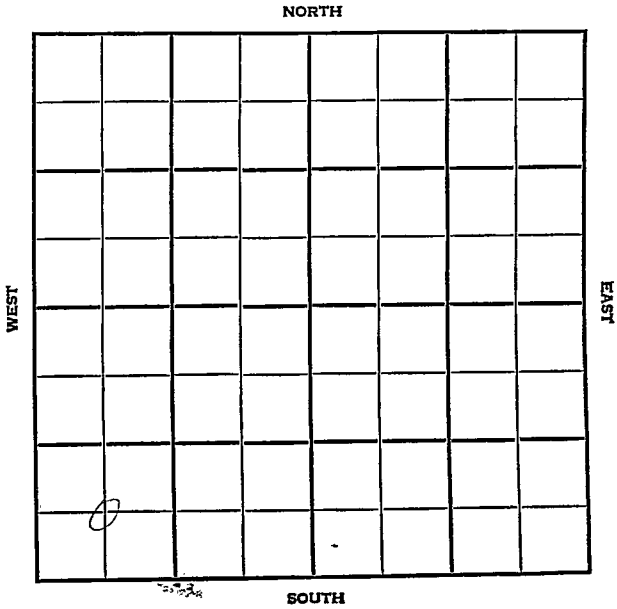

SEC. 26	TWP. 26	R. 13E
------------	------------	-----------

WELL NO.

#1 LaRue

FARM

COMPANY

Geo. R. Jones

CONTRACTOR

Sandling

McWherter


_____ FT. FROM N. LINE

_____ FT. FROM S. LINE

_____ FT. FROM E. LINE

_____ FT. FROM W. LINE

C SW SW

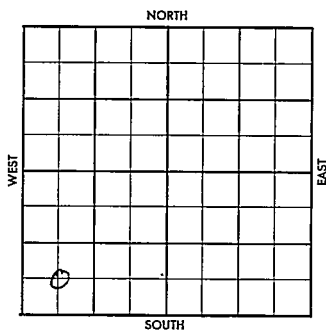

Carter -FO

1956

ELEVATION

953' DF

REPORT

1500' test

6-6

Location

6-12

Comm 6-8-56

8" at 40 w/10 sx

Drlg. 1103

6-20

DST 1484 $\frac{1}{2}$ -86, op 45", rec 17' vso & gcwm

BHP 525/

Ran log

D & A

L. 322', 941', 1067', M 1473'

TD 1486'

ABANDONED

