


DX 78-1

Elk KANSAS

Section 36 Township 28 Range 8E

Well No. 1 Youngmeyer

Company Franco-Central

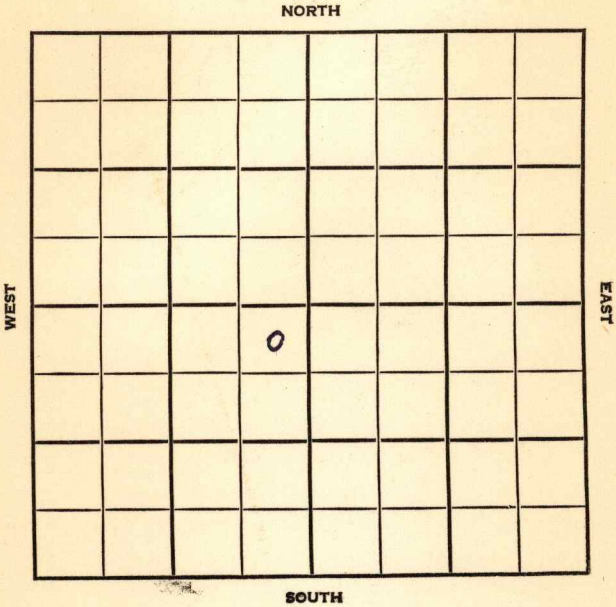

SEC. 36 TWP. 28 R. 8E

WELL NO. 1 Youngmeyer FARM

COMPANY Franco-Central


CONTRACTOR

330 Ft. from N. Line

Ft. from S. Line

330 Ft. from E. Line

Ft. from W. Line

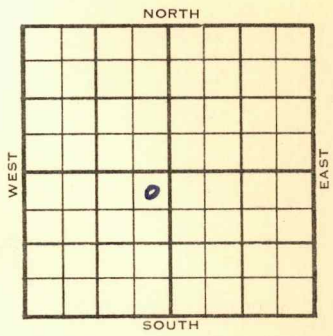

NE NE SW

1954 ELEVATION REPORT

9/1 Drlg. 1140'

