
Woodson KANSAS

SECTION 35 TOWNSHIP 26 RANGE 13 E

WELL NO. #1 Sample

COMPANY Paul Carlson

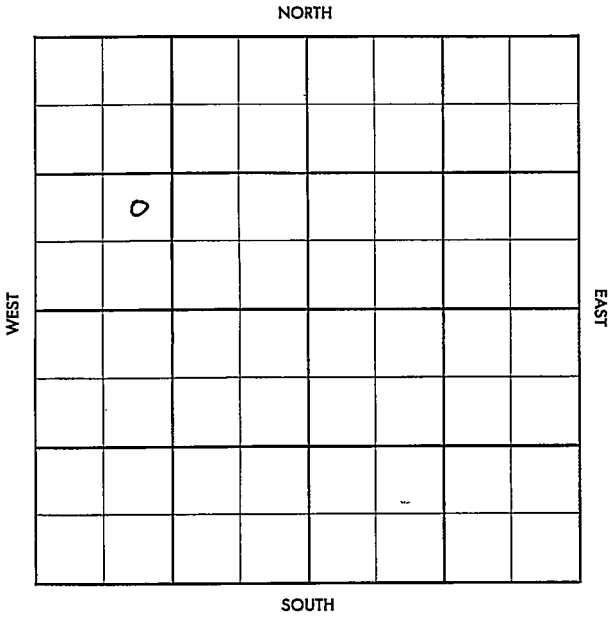

FORM 504-3 SUNRAY

Woodson KANSAS

SEC.	TWP.	R.
35	26	13E

WELL NO. #1 Sample FARM

COMPANY Paul Carlson

CONTRACTOR Co. Tools

McWhirter


_____ Ft. from N. Line

_____ Ft. from S. Line

_____ Ft. from E. Line

_____ Ft. from W. Line

NE SW NW

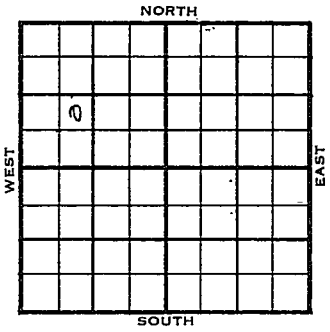

	ELEVATION	
1955	893'	REPORT
12-21	Comm. 12-16-55 10" @ 35 Drlg. 265	
1956		
1-18	8 5/8" @ 590 7" @ 1014 D & A Lans. 257 Pleasing 812 Marm 884 Peru 950 Oswego 1017 Ce. sh. 1096 Chert 1424 TD 1457'	

ABANDONED

DX-78

FORM 513 REV. SUNRAY

County Woodson Elev.

Sec. 35 Twp. 26 Rge. 13E

Company Paul Carlson

Farm Name Sample No. 1

TOPS	DEPTH	LOG	DATUM
Anh.			
T.P.			
H.			
Tr.			
Dg.			
B.L.			
L.			
K.C.			
B.K.C.			
Ce.			
C.			
M.			
M.			
K.			
Mz.			
Mo.			
V.			
S.			
S.			
A			
R.			
P€.			
G.			
T.D.			

Loc. in Sec. NE SW NW

Geol.

Contr. Co. tools

Pool McWhirter

O DEC 21 '55

FIRST REPORT

Date Comm. 12-16-55

10" @ 35 drlg. 265

Co. Lse. No. Sec. T. R.

FORM 513 REV. SUNRAY

County Woodson Elev. 893

Sec. 35 Twp. 26 Rge. 13E

Company Paul Carlson

Farm Name Sample No. 1


TOPS	DEPTH	LOG	DATUM
Anh.			
T.P.			
H. Fabius	257		
Tr. Pleasanton	812		
Dg.	X		
Bl.			
L. Marmaton	884		
K.C. Fern	950		57
B.K.C. Oswego	1017		124
Ce. Shell	1096		203
C.			
M. Ulrich	1424		531
M.			
K.			
Mz.			
Mo.			
V.			
S.			
S.			
A			
R.			
P€.			
G.			
T.D.	1457		

Loc. in Sec. NE SW NW

Geol.

Contr. Co. tools

Pool McWhirter

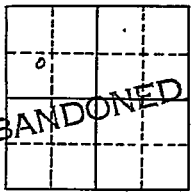

Date Comm. 12-16-55 JAN 18 1956

10" @ 35 8 5/8" @ 590 7" @ 1014

D & A

Co. Lse. No. Sec. T. R.