
Woodson KANSAS

SECTION 35 TOWNSHIP 26 RANGE 13 E

WELL NO. #1 Libbard

COMPANY A. R. Jones

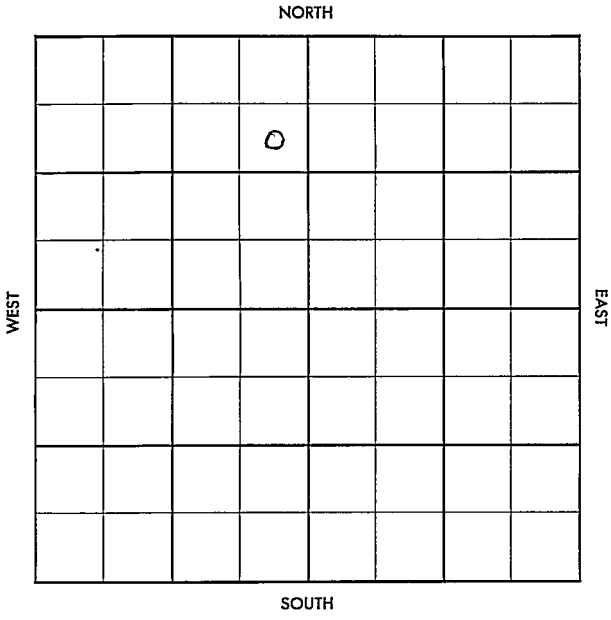

Woodson KANSAS

SEC.	TWP.	R.
35	26	13E

WELL NO.

#1 Hibbard FARM

COMPANY

A.R. Jones

CONTRACTOR

C.H. Barker


_____ Ft. from N. Line

_____ Ft. from S. Line

_____ Ft. from E. Line

_____ Ft. from W. Line

SE NE NW

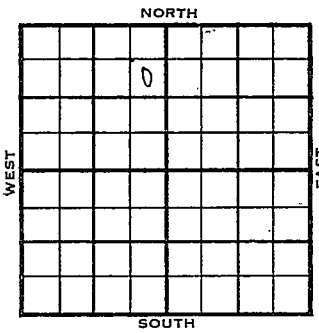

1955	ELEVATION REPORT
12-14	Comm. 12-8-55 Drlg. 450
1956	
1-5	8" @ 604 7" @ 1005 4½" @ 1443 DD 1506 D & A M. 1442 TD 1482'

ABANDONED

DX-78

FORM 513 REV. SUNRAY

County Woodson Elev.

Sec. 35 Twp. 26 Rge. 13E

Company A. R. Jones

Farm Name Hibbard No. 1


TOPS	DEPTH	LOG	DATUM
Anh.			
Tp.			
H.			
Tr.			
Dg.			
Bl.			
L.			
K.C.			
B.K.C.			
Ce.			
C.			
M.			
M.			
K.			
Mz.			
Mq.			
V.			
S.			
S.			
A			
R.			
P€.			
G.			
T.D.			

Loc. in Sec. SE NE NW

Geol.

Contr. C. H. Barker

Pool

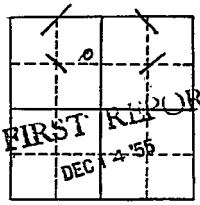

Date Comm. 12-8-55

drlg. 450

Co. Lse. No. Sec. T. R.

FORM 513 REV. SUNRAY

County Woodson Elev.

Sec. 35 Twp. 26 Rge. 13E

Company A. R. Jones

Farm Name Hibbard No. 1


TOPS	DEPTH	LOG	DATUM
Anh.			
T.P.			
H.			
Tr.			
Dg.			
B.L.			
L.			
K.C.			
B.K.C.			
Ce.			
C.			
M.			
M.	1442		
K.			
Mz.			
Mo.			
V.			
S.			
S.			
A			
R.			
P€.			
G.			
T.D.	1482		

Loc. in Sec. SE NE NW

Geol.

Contr.

Pool McWherter

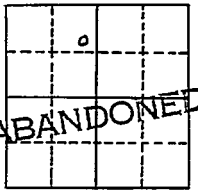

JAN 5 1956

Date Comm. 12-8-55

8" @ 604 7" @ 1005 4½" @ 1443

DD 1506

D & A

Co. Lse. No. Sec. T. R.