



Sec. 2 Twp. 26 R. 14E

Well No. #2 Fegan Farm

O. R. Newcomer Company

Miscellaneous


 Ft. from N. Line

330' Ft. from S. Line

330' Ft. from E. Line

 Ft. from W. Line

SE SW

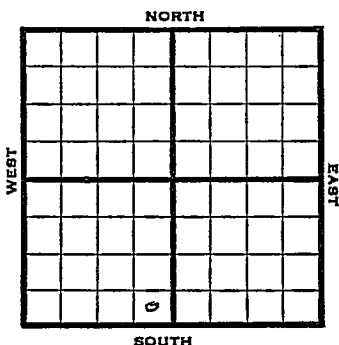

1948

REPORT

- 3/10 Machine
- 3/17 "
- 3/24 "
- 3/31 10" @ 85'
Drlg. 135'
- 4/7 Drlg. 804'
- 4/14 Drlg. 1397'
- 4/21 "
- 4/28 "
- 5/5 "
- 5/12 Bart. 1380'
TD 1412'
Abd.

ABANDONED

Map No. _____ Sec. 2 Twp. 26 R. 14EWell No. 2 FeganO. R. Newcomer CompanyFIRST REPORT Contractor

SE SW

SECTION PLAT

| | | | |
|--|--|--|--|
| | | | |
| | | | |
| | | | |
| | | | |

_____ Ft. from N. Line

330 Ft. from S. Line330 Ft. from E. Line

_____ Ft. from W. Line

Woodson County

Location _____

Rig up _____

Drilling and Remarks:

Machine _____

RECORD

Cased _____ in., _____ ft.

Sand _____

Gas _____

Oil _____

Total Depth _____

PRODUCTION

1st 24 hrs. Nat. _____

1st 24 hrs. after shot _____

Gas _____ Cu. Ft.

Dry Hole _____

Abandoned _____

Date

MAR 10 1948

19

S. J. LEWIS Scout

