



*Woodson*

Map No. KANSAS Sec. 2 Twp. 26 R. 14E


Well No. 1 Hessenplug Farm  
C. L. Shedy Company

\_\_\_\_\_ Ft. from N. Line

330 Ft. from S. Line

330 Ft. from E. Line

\_\_\_\_\_ Ft. from W. Line

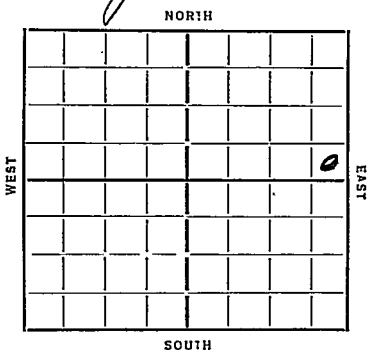

Date	REPORT
<u>1934</u>	
<u>8/29</u>	<u>Dlg 350</u>
<u>9/6</u>	<u>ii 610</u>
<u>9/13</u>	<u>No hope</u>
<u>9/19</u>	<u>Sand 1503-09</u>
	<u>Line 1526 TD 1561 Dr A</u>

**ABANDONED**

Woodson  
Form 26-1M Bks.-2-29

12.4.14

Map No. 17 Sec. 2 Twp. 26 R. 14E

Well No. 1- Hassenplug

C. F. Shedy Company

Contractor

**FIRST REPORTS**

**SECTION PLAT**

\_\_\_\_\_ Ft. from N. Line  
330 Ft. from S. Line  
330 Ft. from E. Line  
\_\_\_\_\_ Ft. from W. Line

			0

Location \_\_\_\_\_

Rig up \_\_\_\_\_

Drilling and Remarks:

Deq 350

**RECORD**

Cased \_\_\_\_\_ in., \_\_\_\_\_ ft.

Sand \_\_\_\_\_

Gas \_\_\_\_\_

Oil \_\_\_\_\_

Total Depth \_\_\_\_\_

**PRODUCTION**

1st 24 hrs. Nat. \_\_\_\_\_

1st 24 hrs. after shot \_\_\_\_\_

Gas \_\_\_\_\_ Cu. Ft.

Dry Hole \_\_\_\_\_

Abandoned \_\_\_\_\_

Date \_\_\_\_\_

8-29-31<sub>19</sub>

**ORVAL MANNSCHECK**

Scout

Map No. 17 Sec. 2 Twp. 26 R. 14E

Well No. 1-Hassenpflug  
C. F. Shedy Company

Contractor

ABANDONED

SECTION PLAT

			o

Ft. from N. Line

330 Ft. from S. Line

330 Ft. from E. Line

Ft. from W. Line

Location.....

Rig up.....

Drilling and Remarks:

10 + FF

RECORD

Cased..... in., ..... ft.

Sand 1503-9

Gas Lime 1526

Oil.....

Total Depth 1561

PRODUCTION

1st 24 hrs. Nat.....

1st 24 hrs. after shot.....

Gas..... Cu. Ft.

Dry Hole.....

Abandoned.....

Date

9-19-37 192

ORVAL MANNSCHECK

Scout