


Map No. KANSAS Sec. 21 Twp. 28 R. 9E

Well No. 1 - Shambaugh Farm
National Refg Company

NORTH

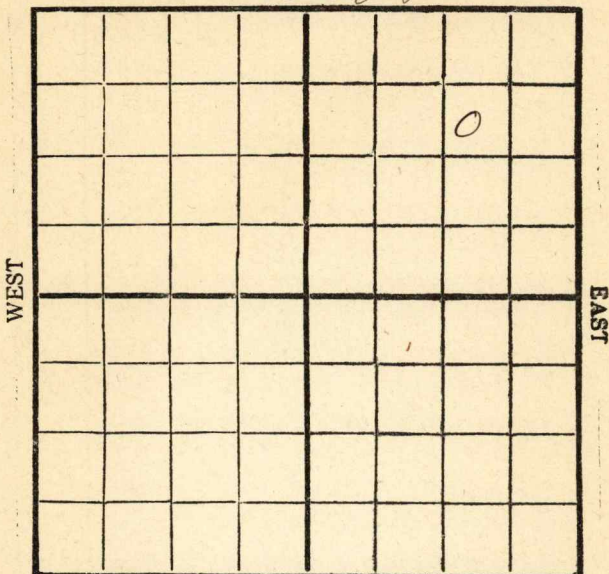

SOUTH

Location _____

Drilling Remarks _____

Rig Up _____

Drilling Remarks _____

RECORD

Cased _____ in. _____ ft.

Sand _____

Gas _____

Oil _____

Total Depth _____

PRODUCTION

1st 24 hrs. Nat. _____

1st 24 hrs. after shot _____


Gas _____ cu. ft. _____

Dry Hole _____

Abandoned _____

Map No. **KANSAS** Sec. 21 Twp. 28 R. 9E
 Well No. 1- Shambaugh Farm
National Refg Company

1020 Ft. from N. Line
 _____ Ft. from S. Line
1020 Ft. from E. Line
 _____ Ft. from W. Line

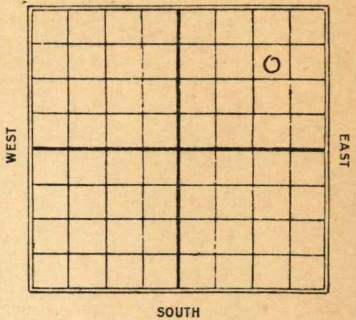

1930

Date	REPORT
2/5	Loc.
2/11	R.G.
2/14	R.G.
2/26	R.G.
3/5	100' 895
3/2	" 1510'
3/19	" 2409'
3/26	Top line 2558 - show 2565-70' R.G. 2624'
4/2	Top line 2558-2720 Sand 2778-2868 HFW R.G. 2906'
4/9	Top line 2558-2720 Sand 2778 HFW 2800 T.D. 2930 Abandon

Elly

Map No. **KANSAS** Sec. *21* Twp. *28* R. *9*

Well No. *1* *Sham bough*
National Regg Co Company

Contractor

COMPLETE

SECTION PLAT

1070 Ft. from N. Line

..... Ft. from S. Line

1070 Ft. from E. Line

..... Ft. from W. Line

ABANDONED

			0

Location.....

Rig up.....

Drilling and Remarks:

top lime 2558-2720

Sand 2778-

Arw 2800'

RECORD

Cased..... in., ft.

Sand.....

Gas.....

Oil.....

Total Depth *2930*

PRODUCTION

1st 24 hrs. Nat.....

1st 24 hrs. after shot.....

Gas..... Cu. Ft.

Dry Hole

Abandoned

Date

APR 9 1930

CHAS. L. SHERWOOD

.....192.....

.....Scout

Else

KANSAS

Map No. Sec. *21* Twp. *28* R. *9^E*

Well No. *1* *Shambaugh*

National Regg Co Company

..... Contractor

FIRST REPORTS

SECTION PLAT

1020 Ft. from N. Line

..... Ft. from S. Line

1020 Ft. from E. Line

..... Ft. from W. Line

			<i>0</i>

Location

Rig up

Drilling and Remarks:

RECORD

Cased..... in., ft.

Sand

Gas

Oil

Total Depth

PRODUCTION

1st 24 hrs. Nat.

1st 24 hrs. after shot

Gas..... Cu. Ft.

Dry Hole.....

Abandoned.....

Date

FEB 5 1930

CHAS. L. SHERWOOD

..... 192

..... Scout