


Map No. _____ Sec. 6 Twp. 28 R. 10Well No. 1-Rader Farm _____Emery et al Company _____

NORTH

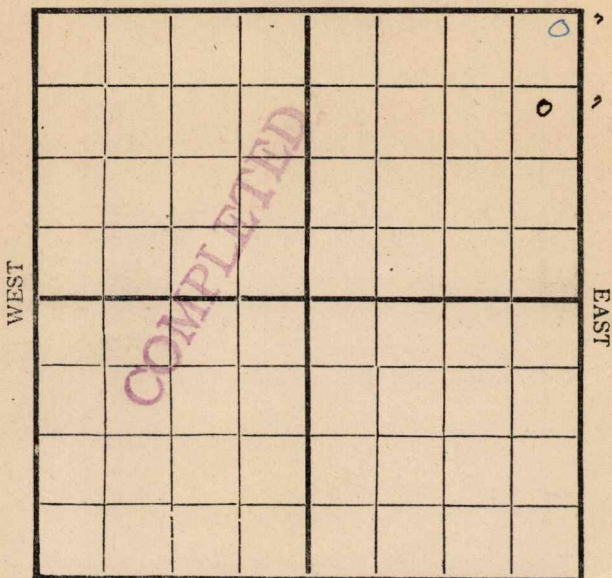

SOUTH

Location 1916Rig Up 11-27-16

Drilling Remarks:

12/9 = R.U.:300 = 12/19:325 = 12/28400 = 1/3/17

Drilling Remarks:

RECORD

Cased _____ in _____ Ft.

Sand _____

Gas _____

Oil _____

Total Depth _____

PRODUCTION

1st 24 hrs. Nat. _____

1st 24 hrs. after shot _____

Gas _____ Cu. Ft.

Dry Hole _____


Abandoned _____

GREENWOOD

Map No. _____ Sec. 6 Twp. 28 R. 10Well No. 1 Rader FarmEmery et al Company

NORTH

WEST

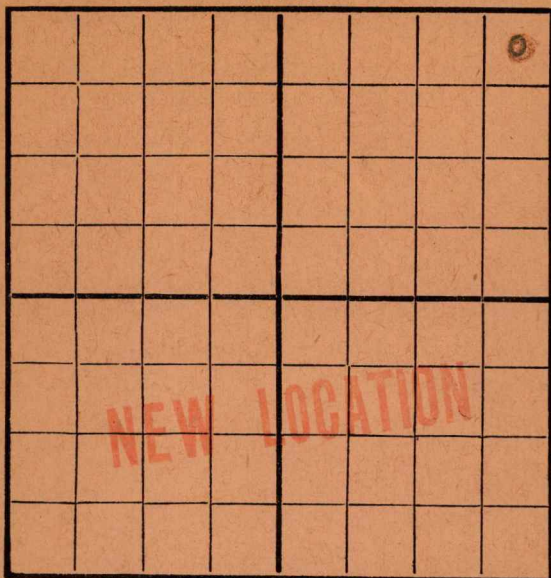

EAST

SOUTH

Location ✓Rig Up ✓

Drilling and remarks _____

RECORD

Cased _____ in. _____ Ft.

Sand _____

Gas _____

Oil _____

Total Depth _____

PRODUCTION

1st 24 hrs. Nat. _____

1st 24 hrs. after shot _____

Gas _____ Cu. Ft.

Dry Hole _____

Abandoned _____

Date

11/271916

E. H. WEST

Scout

GREENWOODMap No. _____ Sec. 6 Twp. 28 R. 10Well No. 1 Rader Farm_____ Emery et al Company

NORTH

							0

WEST

EAST

SOUTH

Location _____

Rig Up ✓ _____

Drilling and remarks _____

RECORD

Cased _____ in. _____ Ft.

Sand _____

Gas _____

Oil _____

Total Depth _____

PRODUCTION

1st 24 hrs. Nat. _____

1st 24 hrs. after shot _____

Gas _____ Cu. Ft.

Dry Hole _____

Abandoned _____

Date

DEC - 2 1916E. H. WEST

191

Scout

GREENWOOD

Map No. Sec. 6, Twp. 28, R. 10

Well No. 1 Rader

Emery et al Company

NORTH							
WEST							0
SOUTH							

Location ✓

Rig up ✓

Drilling and remarks:

RECORD

Cased.....in,Ft.

Sand

Gas

Oil

Total Depth

PRODUCTION

1st 24 hrs. Nat.....

1st 24 hrs. after shot.....

Gas.....Cu. ft.

Dry Hole

Abandoned

Date .

DEC - 9 1916

191


E. H. WEST

Scout

Map No. _____ Sec. 6 Twp. 28 R. 10
 Well No. 1 Rader Farm
E. E. Emery & Co. Company

NORTH

WEST

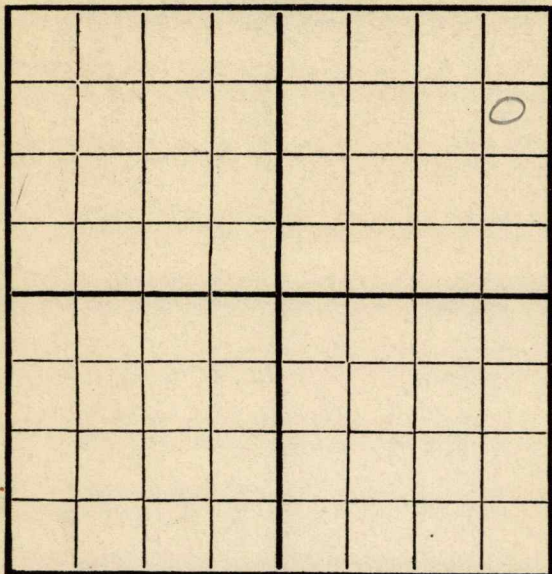

EAST

SOUTH

Location _____

Rig Up _____

Drilling and remarks

Building rig

RECORD

Cased _____ in. _____ Ft.

Sand _____

Gas _____

Oil _____

Total Depth _____

PRODUCTION

1st 24 hrs. Nat. _____

1st 24 hrs. after shot _____

Gas _____ Cu. Ft.

Dry Hole _____

Abandoned _____

Date

12/1, 191 *6* *Melford* Scout


Map No. _____ Sec. 6 Twp. 28 R. 10

Well No. 1 Reader Farm

E. E. Emery Company

NORTH

WEST

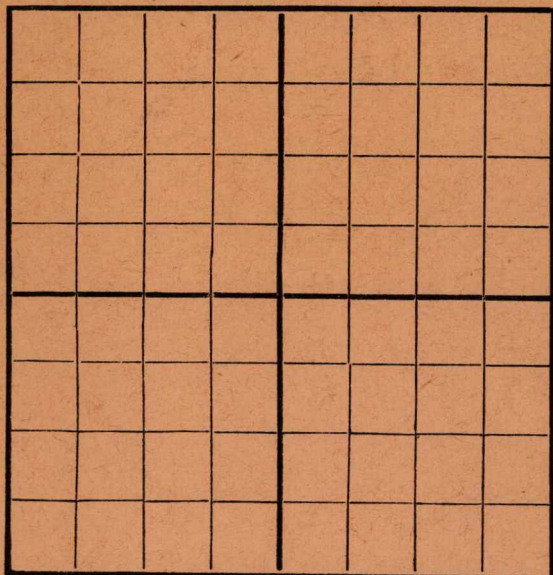

EAST

SOUTH

Location _____

Rig Up _____

Drilling and remarks

300

RECORD

Cased _____ in. _____ Ft.

Sand _____

Gas _____

Oil _____

Total Depth _____

PRODUCTION

1st 24 hrs. Nat. _____

1st 24 hrs. after shot _____

Gas _____ Cu. Ft.

Dry Hole _____

Abandoned _____

Date

10/17

191

6

Tulpea

Scout


GREENWOOD COUNTY

Map No. _____ Sec. 6 Twp. 28 R. 10

Well No. 1 Rader Farm _____
E. C. Enny Company _____

NORTH

WEST

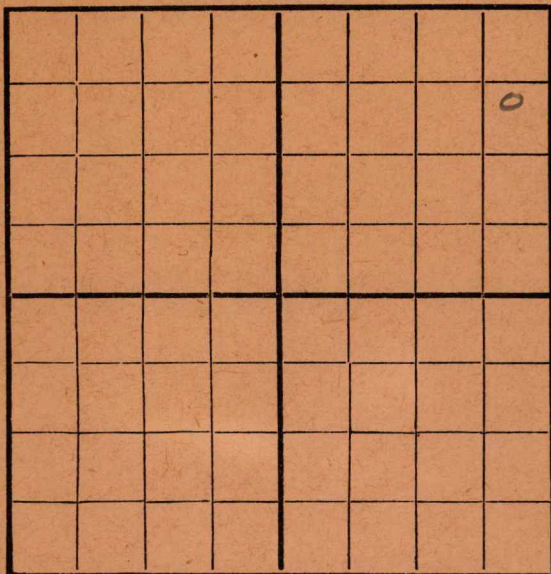

EAST

SOUTH

Location _____

Rig Up _____

Drilling and remarks

325

RECORD

Cased _____ in. _____ Ft.

Sand _____

Gas _____

Oil _____

Total Depth _____

PRODUCTION

1st 24 hrs. Nat. _____

1st 24 hrs. after shot _____

Gas _____ Cu. Ft.

Dry Hole _____

Abandoned _____


Date

12/25, 1916, Mulford Scout

Map No. _____ Sec. 6 Twp. 28 R. 10
 Well No. 1 Wader Farm _____
Emery Company

NORTH

WEST

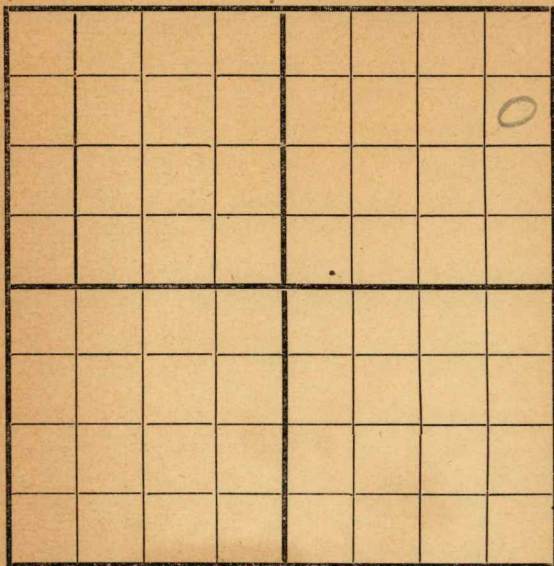

EAST

SOUTH

Location _____

Rig Up _____

Drilling and remarks

400

RECORD

Cased _____ in. _____ Ft.

Sand _____

Gas _____

Oil _____

Total Depth _____

PRODUCTION

1st 24 hrs. Nat. _____

1st 24 hrs. after shot _____

Gas _____ Cu. Ft.

Dry Hole _____

Abandoned _____

Date

1/3, 1917 Melrod Scout


Map No. K9 Sec. 6 Twp. 28 R. 10Well No. 1 RaderEmery et al Company

Contractor

NORTH

WEST

EAST

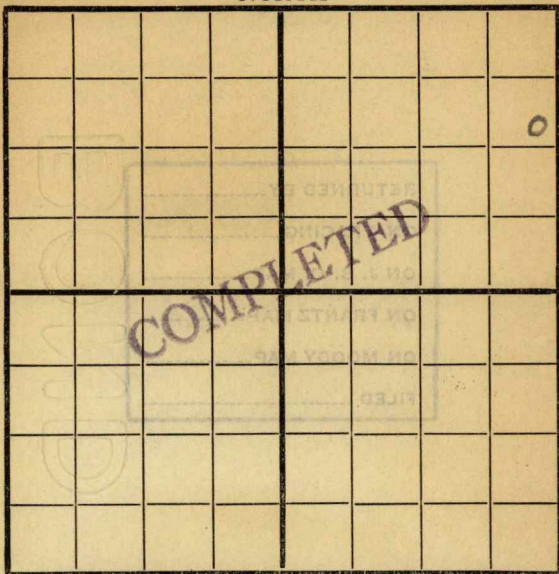

SOUTH

Location _____

Rig up _____

Drilling and Remarks:

RECORD

Cased _____ in., _____ ft.

Sand _____

Gas _____

Oil _____

Total Depth _____

PRODUCTION

1st 24 hrs. Nat. _____

1st 24 hrs. after shot _____

Gas _____ Cu. Ft.

Dry Hole. 2315

Abandoned _____

Date

7/15 1918 Lyke Scout