

KANSAS

FORM 51 5M 8-46 PETROL


McPherson

Section 10 Township 18 Range 1-W

Well No. #1, Wining (KGS DRL)

Company Phillips

13

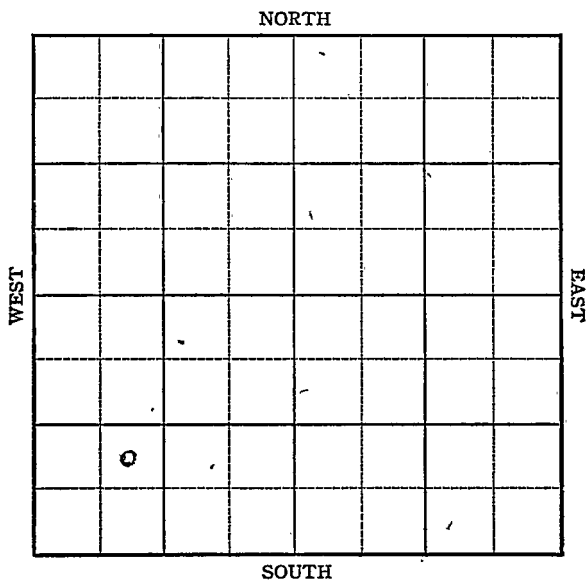

KANSAS

McPherson County

Sec. 10 Twp. 18 R. 1W

Well No. #1⁵ Wining (KGS DRL) Farm

Phillips Company

Battle Hill


Ft. from N. Line

990 Ft. from S. Line

Ft. from E. Line

990 Ft. from W. Line

NE SW SW

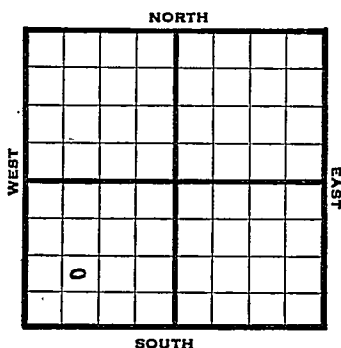

1946

1371 ?

REPORT

9/18	Location		
9/24	10" @ 231 WOC		
10/1	Miss 2671		
	Drlg 2693'		
10/8	Viola 3166-68 TD		
	7" @ 3190 RUST		
10/15	TD 3220-100' W	in	$\frac{1}{2}$ hr
10/22	"	"	"
10/29	"	"	"
11/6	"	"	"
11/12	"	"	"
11/20	"	"	"
11/27	Viola 3166'		
	7" @ 3166'		
	TD 3168'		
	Pump 525 POT		
	35.3 Grav.		

COMPLETED

KANSAS

Kansas Pool Name Battle HillMap No. 42 Sec. 10 Twp. 18 R. 1WWell No. 25 Wining (KLS DRL)Phillips

Company

FIRST REPORT

Contractor

NE SW SW

SECTION PLAT

Ft. from N. Line

990

Ft. from S. Line

Ft. from E. Line

990

Ft. from W. Line

McPherson County

Location XRig up /

Drilling and Remarks:

RECORD

Cased in., ft.Sand Gas Oil Total Depth

PRODUCTION

1st 24 hrs. Nat. 1st 24 hrs. after shot Gas Cu. Ft.Dry Hole Abandoned

Date

SEP 1 8 1946 19

S. J. LEWIS Scout

Map No. 42 Sec. 10 Twp. 18 R. 1W

Well No. 5 Wining (KGS DR2)

Phillips Company

COMPLETED

Contractor

NE SW SW

E1, 1371
SECTION PLAT

 Ft. from N. Line

990 Ft. from S. Line

 Ft. from E. Line

990 Ft. from W. Line

McPherson County

Location

Rig up

Drilling and Remarks:

1102 8166

7 " @ 3166

Prod 525 Bbl.

00000

RECORD

Cased in., ft.

Sand

Gas

Oil

Total Depth 3166

PRODUCTION

1st 24 hrs. Nat.

1st 24 hrs. after shot

Gas Cu. Ft.

Dry Hole

Abandoned

Date

NOV 27 1946 19

S. J. LEWIS

Scout