

KANSAS

FORM 51 5M PETROL


McPherson

Section 10 Township 18 Range 1-W

Well No. #1 Wining

Company Phillips

14

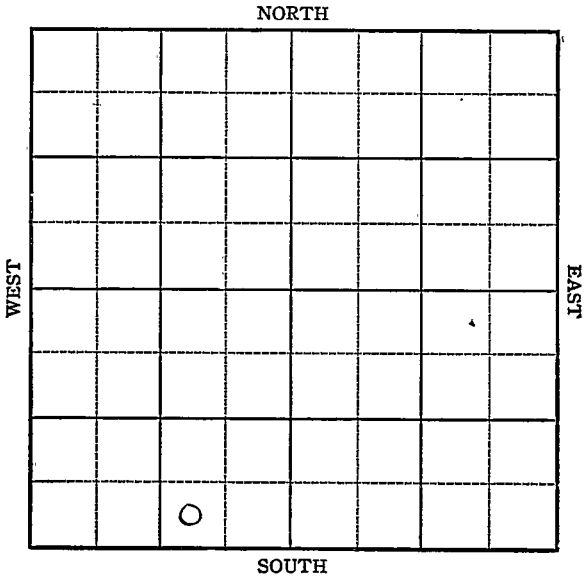

Sec. 10 Twp. 18 R. 1-W

Well No. #1 Wining Farm
Phillips Company


_____ Ft. from N. Line

330 Ft. from S. Line

990 Ft. from E. Line

_____ Ft. from W. Line

Elev. 1389

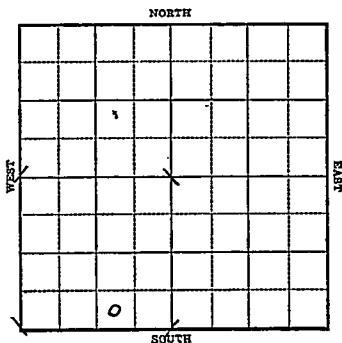

1943

R E P O R T

11/3 Location

11/10 Rotary

11/17 8" @ 250
Drlg. 2053

11/24 Miss 2675'-76 TD
5" @ 2676
RUST

12/ 1 TD 2686
Swb 227 oil 10 hrs.

12/8 " "

12-15 " "

12/22 " "

12/29 Pump 179 oil in 11 hrs

1944

1/5 Miss 2675
TD 2686
5" @ 2676
Pump 459 Pot.
Gravity 39

COMPLETED

KANSAS

Map No. 72 Sec. 10 Twp. 18 R. 1W

Well No. 1 Wining

Phillips

Company

FIRST REPORT

Contractor

SW SE SW

SECTION PLAT

_____ Ft. from N. Line

330

_____ Ft. from S. Line

990

_____ Ft. from E. Line

_____ Ft. from W. Line

Wildcat

Location X

Rig up _____

Drilling and Remarks:

RECORD

Cased _____ in., _____ ft.

Sand _____

Gas _____

Oil _____

Total Depth _____

PRODUCTION

1st 24 hrs. Nat. _____

1st 24 hrs. after shot _____

Gas _____ Cu. Ft.

Dry Hole _____

Abandoned _____

Date

NOV 3 1943 19

S. J. LEWIS Scout

KANSAS

McPherson

Map No. 42 Sec. 10 Twp. 18 R. 1W

Well No. 1 Wining

Phillips Company

COMPLETED Contractor

SW SE SW

SECTION PLAT

_____ Ft. from N. Line

330 Ft. from S. Line

990 Ft. from E. Line

_____ Ft. from W. Line

Wildcat

Location _____

Rig up _____

Drilling and Remarks:

Miss 2625
5" @ 2676
Pump 459 Pst

29° SW

RECORD

Cased _____ in., _____ ft.

Sand _____

Gas _____

Oil _____

Total Depth 2676

PRODUCTION

1st 24 hrs. Nat. _____

1st 24 hrs. after shot _____

Gas _____ Cu. Ft.

Dry Hole _____

Abandoned _____

Date

JAN 5 1944

19

S. J. LEWIS

Scout