


KANSAS

Section 10 Township 18 Range 1W

Well No. 7 Wining

Company Phillips

Battle Hill NORTH

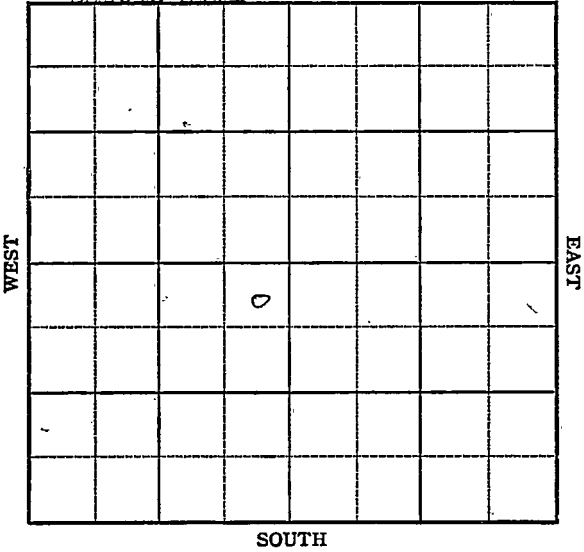

Sec. 10 Twp. 18 R. 1W ✓

Well No. 7 Wining Farm

Phillips Company

McPherson County

NORTH

330 Ft. from N. Line

_____ Ft. from S. Line


330 Ft. from E. Line

_____ Ft. from W. Line

NE SW

Elev. 1391'

SOUTH

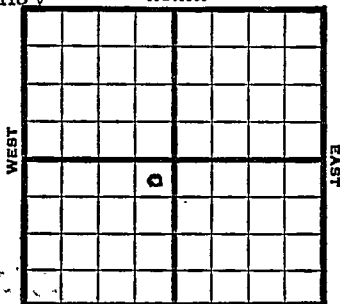

1947

REPORT

- 3/26 Location
- 4/2 8" @ 256'
Drlg. 1673'.
- 4/9 Miss 2695'
Viola 3153-55
Run 5"
- 4/15 5" @ 3153'
TD 3165'
500 Acid
Shot 29 bbls. oil in 6 hrs.
- 4/23 " " "
- 4/29 " " "
- 5/7 " " "
- 5/13 TD 3165'
- 5/21 Viola 3153'
5" @ 3153'
2500 Acid
Pump 437 Pot
Grav. 36
TD 3165'

COMPLETED

Map No. K42 Sec. 10 Twp. 18 R. 1W

Well No. 7 Wining

Phillips Company

FIRST REPORT Contractor

NE SW

330 Ft. from N. Line

 Ft. from S. Line

330 Ft. from E. Line

 Ft. from W. Line

SECTION PLAT

	o		

McPherson County

Location X

Rig up

Drilling and Remarks:

RECORD

Cased in., ft.

Sand

Gas

Oil

Total Depth

PRODUCTION

1st 24 hrs. Nat.

1st 24 hrs. after shot

Gas Cu. Ft.

Dry Hole

Abandoned

Date

MAR 26 1947 19

S. J. LEWIS

Scout

Map No. K42 Sec. 10 Twp. 18 R. 1W

Well No. 7 Wining

Phillips Company

COMPLETE

Contractor

NE SW

E 11391
SECTION PLAT

330 Ft. from N. Line

 Ft. from S. Line

330 Ft. from E. Line

 Ft. from W. Line

	o		

McPherson County

Location

Rig up

Drilling and Remarks:

Water 8153

5" @ 8153

2000 acid

Prod 437 Bbl

36-1/2

RECORD -

Cased in., ft.

Sand

Gas

Oil

Total Depth 8165

PRODUCTION

1st 24 hrs. Nat.

1st 24 hrs. after shot

Gas Cu. Ft.

Dry Hole

Abandoned

Date

MAY 21 1947 19

S. J. LEWIS Scout