

Map No. _____ Sec. 6 Twp. 26 R. 14

Well No. 1 Jones Farm

Walter O. G. _____ Company

NORTH

WEST

COMPLETED

EAST

SOUTH

Location _____

Drilling Remarks

9/30 - 3000' *Repping up*
10/7 - 1050
10/14 - 1420 - S

9/30 - 130/0'

1/K017-1050

10/14-1420-S10

Rig Up-----

Drilling Remarks

ad
.....







[illegible]

[illegible]

=====

1 2 104

Abstract

[illegible]

PRODUCTION

1st 24 hrs. Not

1st 24 hrs. after shot

G. E.

✓

✓

Abandoned -----

RECORD

Cased_____ in. _____Ft.

Sand.....

Gas _____

Oil_____

Total Depth 1625

PRODUCTION

1st 24 hrs. Nat.-----

1st 24 hrs. after shot-----

Gas _____ Cu. Ft.

Dry Hole.....✓

Abandoned ✓-----


Woodson

Map No. _____ Sec. 6 Twp. 26 R. 14Well No. #1 Jones Farm _____

Atlas Oil & Gas Company

NORTH

WEST

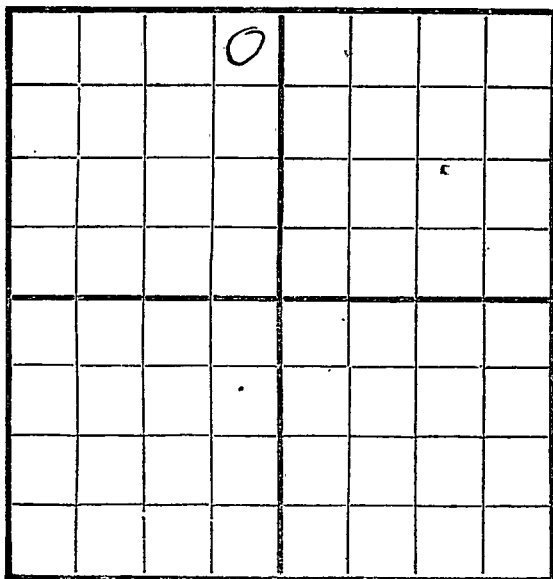

EAST

SOUTH

Location _____

Rig Up _____

Drilling and remarks _____

RECORD

Cased _____ in. _____ Ft.

Sand _____

Gas _____

Oil _____

Total Depth 1625

PRODUCTION

1st 24 hrs. Nat. _____

First 24 hrs. after shot _____

Gas _____ Cu. Ft.

Dry Hole ☒Abandoned ☒

Date

10/15, 1911

Scout

COMPLETED