

KANSAS


FORM 51 5M PETROL

Woodson ✓

Section 7 Township 26 Range 14-E

Well No. #1 Faggen

Company Havlic

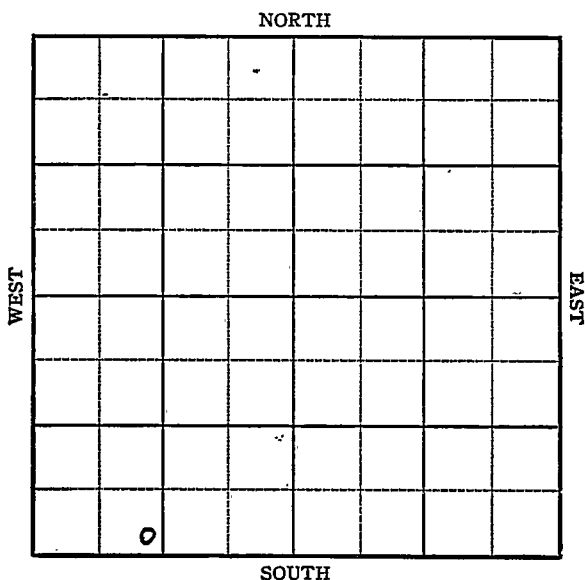

KANSAS

Woodson

Sec. 7 Twp. 26 R. 14-EWell No. #1, Faggen FarmHavlic Company

Ft. from N. Line

160~~660~~


Ft. from S. Line

~~660~~

Ft. from E. Line

870

Ft. from W. Line

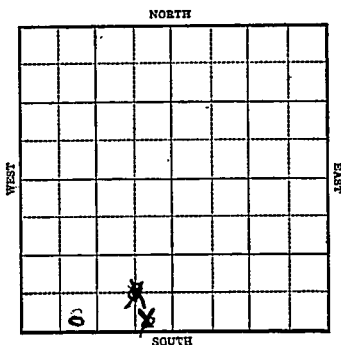

R E P O R T

1943

12/15

Machine

12/22

Drlg. 710'

12/29

SD

1944

1-5

"

1-12

"

1/19

"

1/26

8" @ 835

7" @ 1370

Miss 1247

Drlg. 1490

2/2

Miss 1247

TD 1490

ABANDONED

KANSAS
 Map No. 147 Sec. 7 Twp. 26 R. 14E

Well No. 1 Faggen

Havlic


Company

FIRST REPORT

Contractor

C SE SW

SECTION PLAT

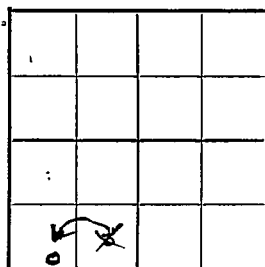

Ft. from N. Line

160

Ft. from S. Line

660

Ft. from E. Line

810
660

Ft. from W. Line

Miscellaneous

Location _____

Rig up _____

Drilling and Remarks:

Machine

*The other well
in this area was
plugged*

RECORD

Cased _____ in., _____ ft.

Sand _____

Gas _____

Oil _____

Total Depth _____

PRODUCTION

1st 24 hrs. Nat. _____

1st 24 hrs. after shot _____

Gas _____ Cu. Ft.

Dry Hole _____

Abandoned _____

Date

DEC 15 1943

19

S. J. LEWIS

Scout

We already show
a #1 well in
this 40 acres

Sandy: We already show a well drilled
in this 40 acres. Check and advise
Sam

Misc Small Maps	<i>Over</i>
Cards	<i>Wedge</i>
Tracing	<i>MEH</i>
Trance Map	☒
Contour Map	<i>PP</i>
Moody Map	☒
Crological Dept	
Moody Plot Book	

KANSAS
Map No. 7 Sec. 7 Twp. 26 R. 14E

Well No. 1 Faggen


Havlic Company

CORRECTION

Contractor

SE SW SW

SECTION PLAT

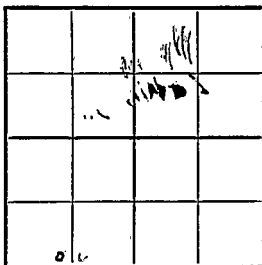

_____ Ft. from N. Line

160 Ft. from S. Line

_____ Ft. from E. Line

810 Ft. from W. Line

Miscellaneous

Location _____

Rig up _____

Drilling and Remarks:

Reported

C SE SW

Correct to
SE SW SW
160-5 Lines
810 IN
sum

RECORD

Cased _____ in., _____ ft.

Sand _____

Gas _____

Oil _____

Total Depth _____

PRODUCTION

1st 24 hrs. Nat. _____

1st 24 hrs. after shot _____

Gas _____ Cu. Ft.

Dry Hole _____

Abandoned _____

Date

DEC 22 1943


19

S. J. LEWIS

Scout

Please check spot, and feet measurements.

Oma

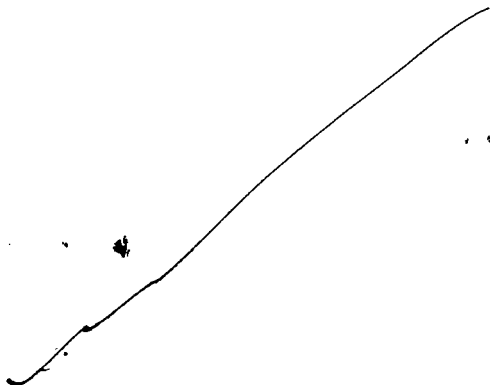

Misc. Small Maps	<i>Oma</i>
Cards	<i>Madge</i>
Tracing	<i>MSL</i>
France	<i>✓</i>
Scarb	<i>✓</i>
Moody Map	<i>✓</i>
Geological Dept.	<i>✓</i>
Moody Plat Book	<i>✓</i>

KANSAS

Map No. 17 Sec. 7 Twp. 26 R. 14EWell No. 1 FaggenHavlic Company

ABANDONED

Contractor

SE SW SW

SECTION PLAT

 Ft. from N. Line160 Ft. from S. Line Ft. from E. Line810 Ft. from W. Line

Miscellaneous

Location Rig up

Drilling and Remarks:

Mar 1247

RECORD

Cased in., ft.Sand Gas Oil Total Depth 1490

PRODUCTION

1st 24 hrs. Nat. 1st 24 hrs. after shot Gas Cu. Ft.Dry Hole Abandoned

Date

FEB 2 1944

19

S. J. LEWIS

Scout