


Map No. _____ Sec. 2 Twp. 29 R. 4

Well No. 1. Krueger Farm _____
Valley Chief Oil Co. Company _____

NORTH

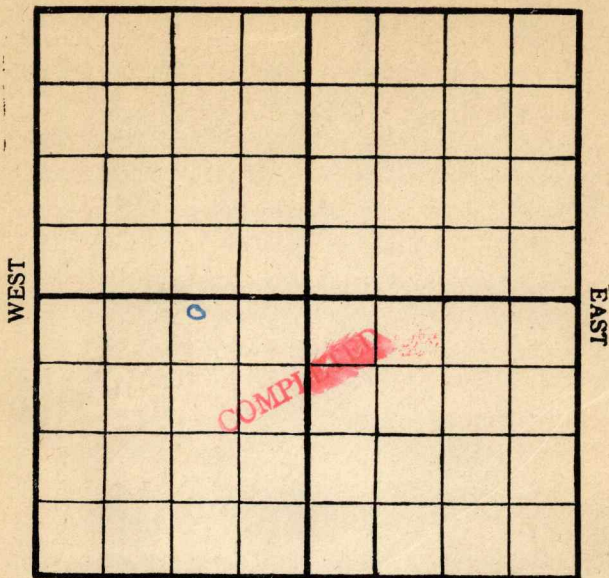

SOUTH

Location _____

Rig Up _____

Drilling Remarks:

Drilling Remarks:

RECORD

PRODUCTION

Cased _____ in. _____ ft.

1st 24 hrs. Nat. _____

Sand _____

1st 24 hrs. after shot _____

Gas _____

Gas _____ cu. ft.

Oil _____

Dry Hole _____

Total Depth _____

Abandoned _____

Map No. R11 Sec. 2 Twp. 29 R. 4Well No. 1 KrugerValley Creek Company

Contractor

NORTH

WEST

EAST

SOUTH

Location _____

Rig up ☒ _____

Drilling and Remarks:

RECORD

Cased _____ in., _____ ft.

Sand _____

Gas _____

Oil _____

Total Depth _____

PRODUCTION

1st 24 hrs. Nat. _____

1st 24 hrs. after shot _____

Gas _____ Cu. Ft.

Dry Hole _____

Abandoned _____

FIRST REPORT

Date

7/23 1918 Candy Scout

Map No. 1511 Sec. 2 Twp. 29 R. 4

Well No. 1 Truzyer
Valley Chief Company
Contractor

Contractor

NORTH

WEST

EAST

SOUTH

200 N-11208. SOUT

Location _____

Rig up_____

Drilling and Remarks:

600

RECORD

Cased _____ in., _____ ft.

Sand_____

Gas

Oil _____

Total Depth.....

PRODUCTION

1st 24 hrs. Nat. -----

1st 24 hrs. after shot-----

Gas.....Cu. Ft.

Dry Hole_____

Abandoned.....

Date _____

9/18

191

Quincy

Scout

Map No. 1511 Sec. 2 Twp. 29 R. 4Well No. 1511
Valley Oil Co. Company
Contractor

NORTH

WEST

EAST

SOUTH

RECORD

Location _____

Cased _____ in., _____ ft.

Rig up _____

Sand _____

Drilling and Remarks:

Gas _____

Oil _____

Total Depth _____

PRODUCTION

1st 24 hrs. Nat. _____

1st 24 hrs. after shot _____

Gas _____ Cu. Ft.


Dry Hole _____

Abandoned _____

Date

9/21 - 8 Carley Scout
191

Map No. 1511 Sec. 2 Twp. 29 R. 4
Well No. 1511-2-29-4
Company Valley Oil Co.
Contractor

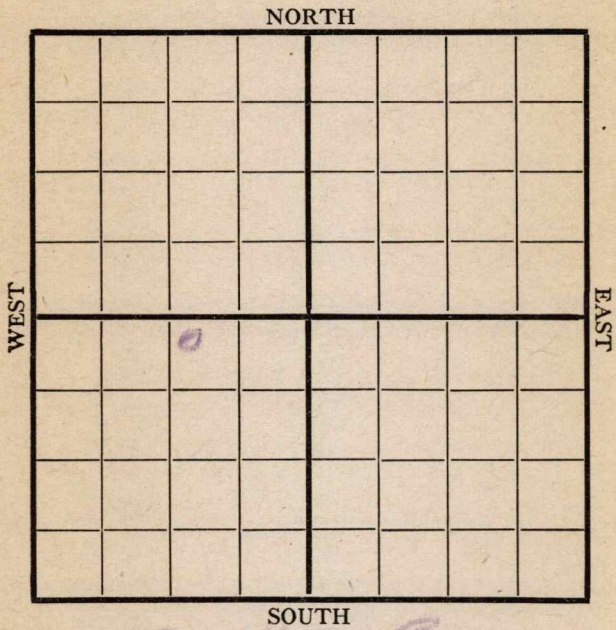

200 X 11 20 E

	RECORD	
Location _____	Cased _____ in., _____ ft.	
Rig up _____	Sand _____	
Drilling and Remarks:	Gas _____	
<u>Fishing</u> <u>800'</u>	Oil _____	
	Total Depth _____	
	=====	
	PRODUCTION	
	1st 24 hrs. Nat. _____	
	1st 24 hrs. after shot _____	
	Gas _____ Cu. Ft.	
	Dry Hole _____	
	Abandoned _____	

Date 10/2 191 8 C. C. C. Scout


Map No. K11 Sec. 2 Twp. 29 R. 4Well No. TruggerValley Chief Company

Contractor

NORTH

WEST

EAST

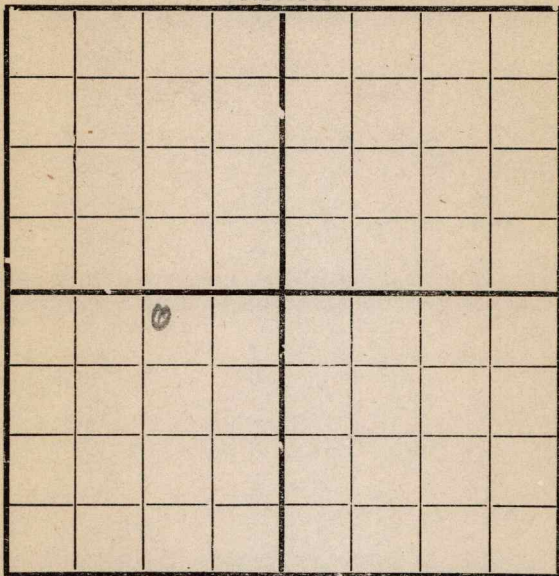

SOUTH

Location _____

Rig up _____

Drilling and Remarks:

Fishing
820

RECORD

Cased _____ in., _____ ft.

Sand _____

Gas _____

Oil _____

Total Depth _____

PRODUCTION

1st 24 hrs. Nat. _____

1st 24 hrs. after shot _____

Gas _____ Cu. Ft.

Dry Hole _____

Abandoned _____

Date

11/13 191 *8* *Carney* Scout


Map No. 1511 Sec. 2 Twp. 29 R. 4Well No. 1 KrugerValley Oil Co. Company

Contractor

NORTH

WEST

EAST

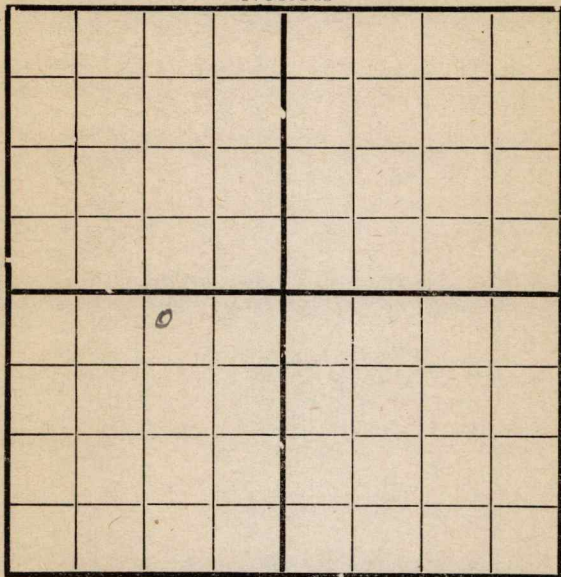

SOUTH

Location _____

Rig up _____

Drilling and Remarks:

1000

RECORD

Cased _____ in., _____ ft.

Sand _____

Gas _____

Oil _____

Total Depth _____

PRODUCTION

1st 24 hrs. Nat. _____

1st 24 hrs. after shot _____

Gas _____ Cu. Ft.

Dry Hole _____

Abandoned _____

Date

11/30

191

S. Carney

Scout


Map No. K11 Sec. 2 Twp. 29 R. 4Well No. 1711Valley Chief Company

Contractor

NORTH

WEST

EAST

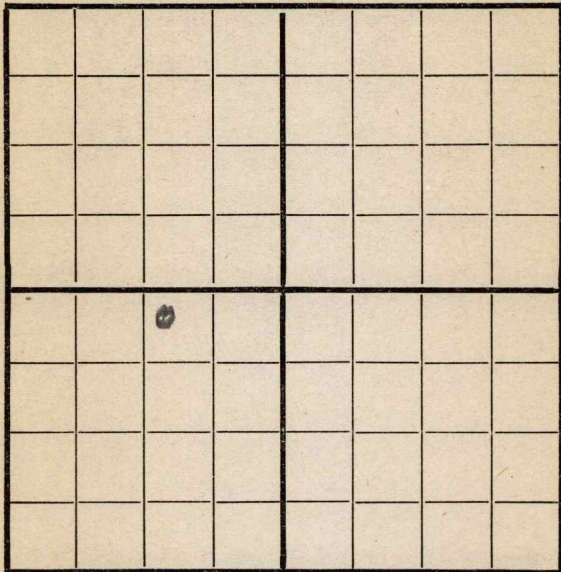

SOUTH

Location _____

Rig up _____

Drilling and Remarks:

1400

RECORD

Cased _____ in., _____ ft.

Sand _____

Gas _____

Oil _____

Total Depth _____

PRODUCTION

1st 24 hrs. Nat. _____

1st 24 hrs. after shot _____

Gas _____ Cu. Ft.

Dry Hole _____

Abandoned _____

Date


11/27 1918 S. Carley Scout

Map No. 511 Sec. 2 Twp. 29 R. 4

Well No. 1 Trigger

Valley City Company
Contractor

NORTH

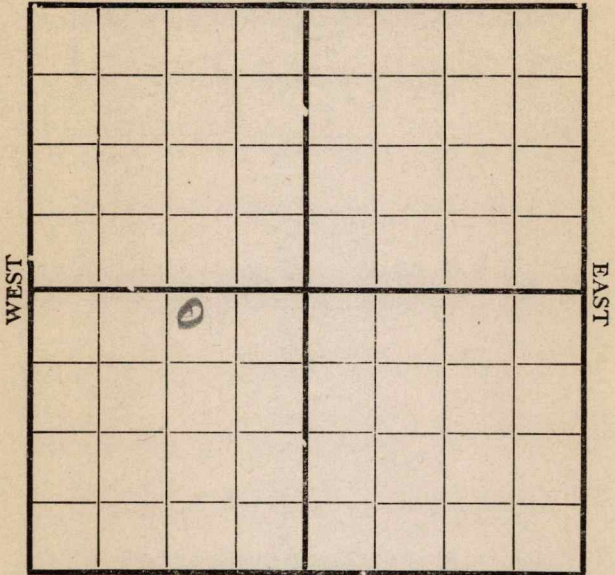

SOUTH

200 x 1120

Location _____

Rig up _____

Drilling and Remarks:

1830 set
8 in

RECORD

Cased _____ in., _____ ft.

Sand _____

Gas _____

Oil _____

Total Depth _____

PRODUCTION

1st 24 hrs. Nat. _____

1st 24 hrs. after shot _____

Gas _____ Cu. Ft.

Dry Hole _____

Abandoned _____

Date

12/4 191 8 Conley Scout

Map No. K11 Sec. 2 Twp. 29 R. 4

Well No. 1 Trigger
Valley Chief Company
 Contractor

NORTH

WEST

EAST

		0					

SOUTH

Location _____

Rig up _____

Drilling and Remarks:

2200

RECORD

Cased _____ in., _____ ft.

Sand _____

Gas _____

Oil _____

Total Depth _____

PRODUCTION

1st 24 hrs. Nat. _____

1st 24 hrs. after shot _____

Gas _____ Cu. Ft.

Dry Hole _____

Abandoned _____

Date


12/11 191 S. C. Cady Scout

Map No. K11 Sec. 2 Twp. 29 R. 4
 Well No. 1 Kruger
Valley Child Company
 Contractor

NORTH

WEST

EAST

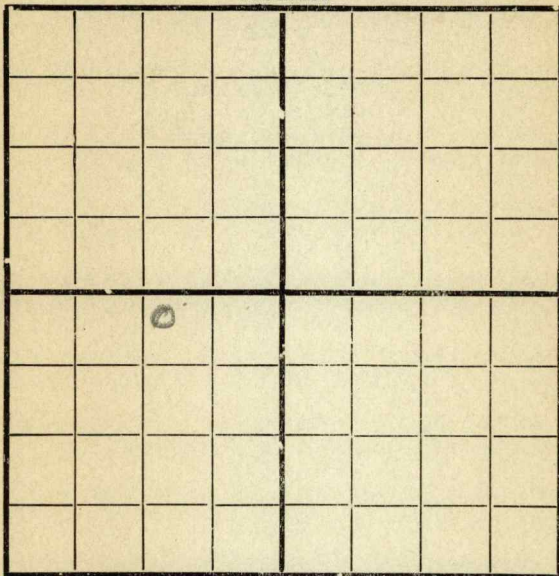

SOUTH

200K-11208

Location _____

Rig up _____

Drilling and Remarks:

2290

RECORD

Cased _____ in., _____ ft.

Sand _____

Gas _____

Oil _____

Total Depth _____

PRODUCTION

1st 24 hrs. Nat. _____

1st 24 hrs. after shot _____

Gas _____ Cu. Ft.

Dry Hole _____

Abandoned _____

Date

12/18 191 S. Candy Scout

Map No. *K 11* Sec. *2* Twp. *29* R. *4*Well No. *Truoggen*


Company

Contractor

NORTH

WEST

EAST

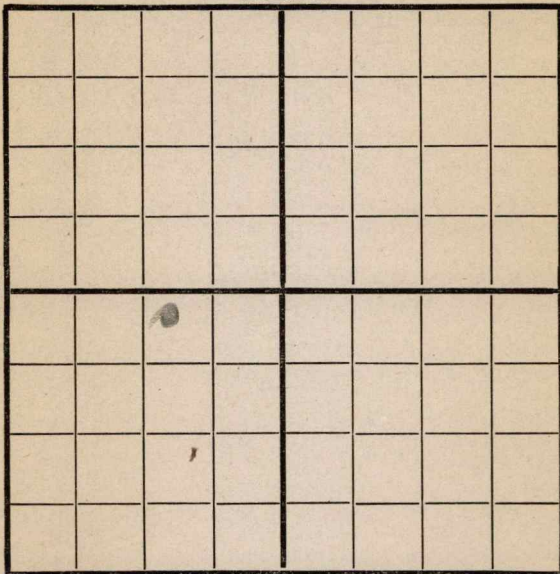

SOUTH

200 K 11 20 E

Location

Rig up

Drilling and Remarks:

*2 D. for
pige
2300*

RECORD

Cased _____ in., _____ ft.

Sand _____

Gas _____

Oil _____

Total Depth _____

PRODUCTION

1st 24 hrs. Nat. _____

1st 24 hrs. after shot _____

Gas _____ Cu. Ft.

Dry Hole _____

Abandoned _____

Date

12/25/8 *C. C. C.* *191* Scout

Map No. K11 Sec. 2 Twp. 29 R. 4
Well No. 1 Krugger
Valley Chief - Company _____
Contractor _____

NORTH

EAST

WEST

SOUTH.

RECORD

Location _____

Cased _____ in., _____ ft.

Rig up.....

Sand_____

Drilling and Remarks:

Gas

Oil _____

Total Depth.....

PRODUCTION

1st 24 hrs. Nat. _____

1st 24 hrs. after shot-----

Gas_____Cu. Ft.

Dry Hole

Abandoned.....

Date _____

1919

Pyle

Scout

3/8

Butler
 K11
 MAP NO. **KANSAS** SEC. *2* TWP. *29S* R. *4E*

WELL NO. *1 Krugger*

Valley Chief COMPANY

CONTRACTOR

ABANDONED

SECTION PLAT

	0		

_____ FT. FROM N. LINE

_____ FT. FROM S. LINE

_____ FT. FROM E. LINE

_____ FT. FROM W. LINE

LOCATION _____

RIG UP _____

DRILLING AND REMARKS:

RECORD

CASED _____ IN. _____ FT.

SAND _____

GAS _____

OIL _____

TOTAL DEPTH *3005*

PRODUCTION

1ST 24 HRS. NAT. _____

1ST 24 HRS. AFTER SHOT _____

GAS _____ CU. FT.

DRY HOLE ☒

ABANDONED ☒

DATE

5/14 19*19* SCOUT


Map No. K11 Sec. 2 Twp. 29 R. 4Well No. 1 KrupperValley Chief 045 Company

Contractor

NORTH

WEST

EAST

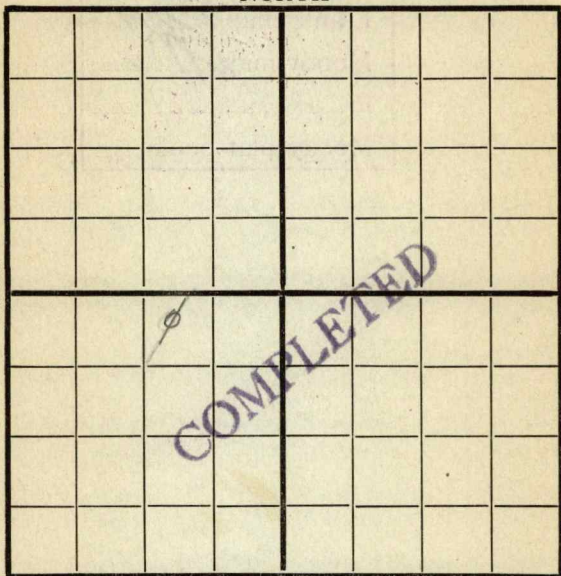

SOUTH

200 N1120 E

RECORD

Location _____

Cased _____ in., _____ ft.

Rig up _____

Sand _____

Drilling and Remarks:

Gas _____

Oil _____

Total Depth _____

PRODUCTION

1st 24 hrs. Nat. _____

1st 24 hrs. after shot _____

Gas _____ Cu. F

Dry Hole 3005

Abandoned _____

Date

6/10 191 9 Cyle