

KANSAS

Woodson


FORM 51 IOM 12-46 PETROL



Section 7 Township 26 Range 14E

Well No. 1 Puckett

Company Iowa Oil & Ref.

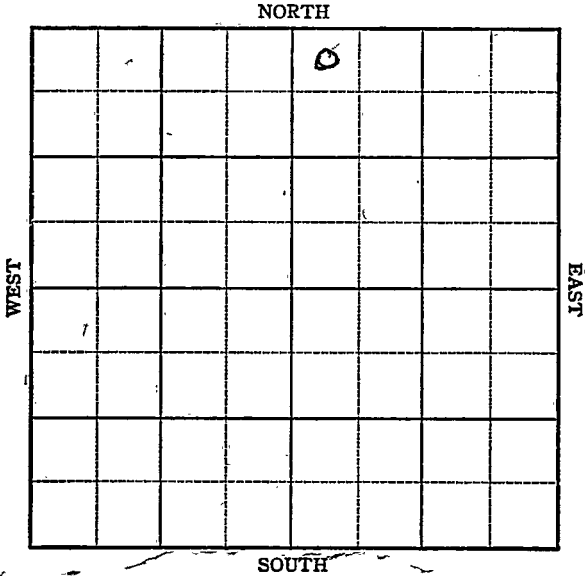

Sec. 7 Twp. 26 R. 14E

Well No. 1 Puckett Farm

Iowa Oil & Ref. Company

Misc.


330 Ft. from N. Line

_____ Ft. from S. Line

_____ Ft. from E. Line

330 Ft. from W. Line

NW NE

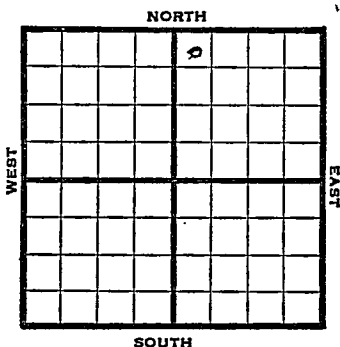

1947

REPORT

5/21 12 1/2" @ 85'
10" @ 730'
Drlg. 785'.

5/27 " "

6/3 TD 1575'

6/10 " "

6/18 Miss. 1488'
TD 1575'

ABANDONED

Map No. 17 Sec. 7 Twp. 26 R. 14E

Well No. 1 Puckett

Iowa Oil & Ref. Company

ABANDONED Contractor

NW NE

SECTION PLAT

330 Ft. from N. Line

_____ Ft. from S. Line

_____ Ft. from E. Line

330 Ft. from W. Line

		0	

Woodson County

Location _____

Rig up _____

Drilling and Remarks:

Mis 1488

RECORD

Cased _____ in., _____ ft.

Sand _____

Gas _____

Oil _____

Total Depth 1575

PRODUCTION

1st 24 hrs. Nat. _____

1st 24 hrs. after shot _____

Gas _____ Cu. Ft.

Dry Hole _____

Abandoned _____

Date

JUN 18 1947 19

S. J. LEWIS Scout