


KANSAS

Barton County

Section 21 Township 16 Range 11W

Well No. #2 Martha Laudick

Company Sinclair-Prairie

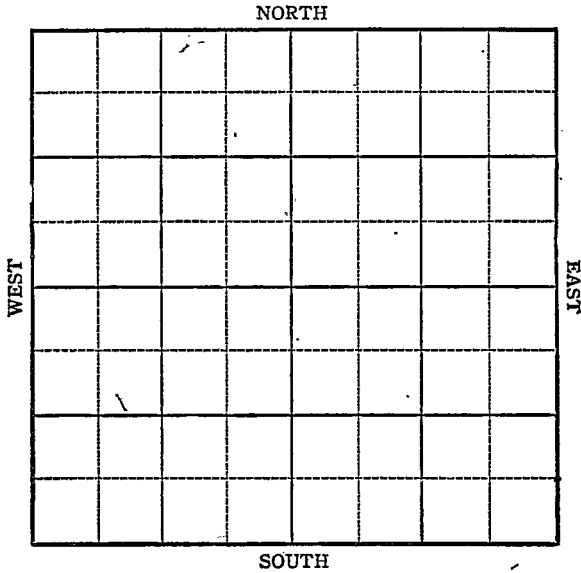

Sec. 21 Twp. 16 R. 11W

Well No. #2 Martha Laudick Farm

Sinclair-Prairie Company


Kraft-Prusa

330 Ft. from N. Line

_____ Ft. from S. Line

990 Ft. from E. Line

_____ Ft. from W. Line

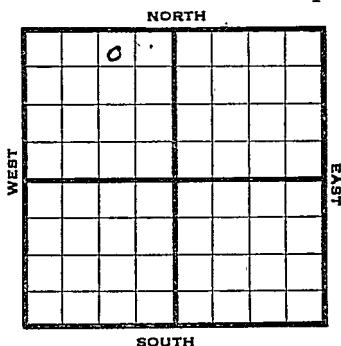

NW NE NW

1945

R E P O R T

1/17 R U R
 1/26 9" @ 368'
 Drlg. 1220'
 1/31 Drlg. 3040'
 2/7 Arb 3260
 TD 3275 SO
 5" @ 3275 RUST
 2/14 " " " "
 2/21 Lans 2990
 30 shots 3258-66 2000 oil
 2-3/4 hrs 1000 acid
 2/28 Pump 455 oil in 22 hrs
 3/7 " " " " " "
 3/14 Arb. 3260
 5" @ 3275'
 Perf. Arb. 1000 acid
 TD 3275
 Depth Pot. 2166
 Grav. 42.2

COMPLETED

KANSASPool Name Kraft-PrusaMap No. _____ Sec. 21 Twp. 16 R. 11WWell No. 2 Martha LaudickSinclair-Prairie Company**FIRST REPORT**

Contractor _____

NW NE NW

SECTION PLAT330 Ft. from N. Line

_____ Ft. from S. Line

990 Ft. from E. Line

_____ Ft. from W. Line

	0		

Barton

Location _____

Rig up _____

Drilling and Remarks:

R U R

RECORD

Cased _____ in., _____ ft.

Sand _____

Gas _____

Oil _____

Total Depth _____

PRODUCTION

1st 24 hrs. Nat. _____

1st 24 hrs. after shot _____

Gas _____ Cu. Ft.

Dry Hole _____

Abandoned _____

Date

JAN 17 1945 19S. J. LEWIS Scout

Pool Name Kraft-Prusa

Map No. 55 Sec. 21 Twp. 16 R. 11W

Well No. 2 Martha Laudick

Sinclair-Prairie Company

COMPLETED Contractor

NW NE NW

SECTION PLAT

330 Ft. from N. Line

_____ Ft. from S. Line

990 Ft. from E. Line

_____ Ft. from W. Line

	0		

Barton

Location _____

Rig up _____

Drilling and Remarks:

Cr 83260
5" 83275
Perf Cr 8
10000 acid
Dept 8 2166
422 gr

RECORD

Cased _____ in., _____ ft.

Sand _____

Gas _____

Oil _____

Total Depth 3225

PRODUCTION

1st 24 hrs. Nat. _____

1st 24 hrs. after shot _____

Gas _____ Cu. Ft.

Dry Hole _____

Abandoned _____

Date

MAR 14 1945

S. J. LEWIS Scout