





N

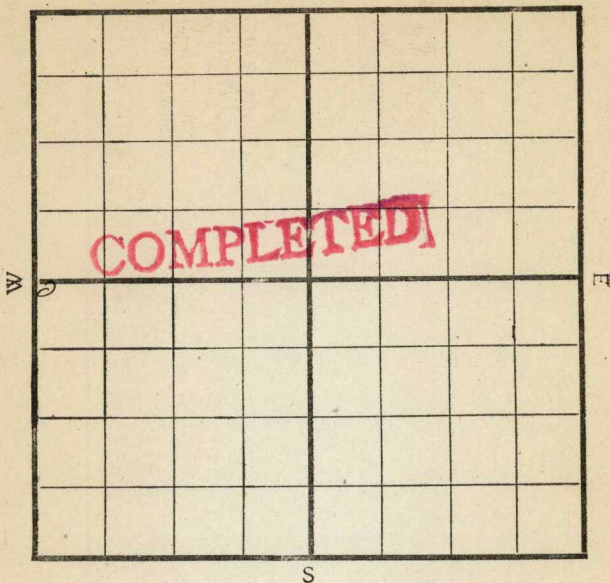

Location _____

Drilling Remarks:

Rig Up -----

Drilling Remarks:

RECORD

Cased ----- in.-----ft.

Sand -----

Gas -----

Oil _____

Total Depth-----

PRODUCTION

1st 24 hrs. Nat.-----

1st 24 hrs. after shot-----

Gas ----- cu. ft.

Dry Hole -----

Abandoned -----

Map No. K 11 Sec. 2 Twp. 29 R. 4Well No. 2 KruegerKaneas Wyoming Oil Company

Contractor

SECTION PLAT

50' Ft. from N. Line

Ft. from S. Line

Ft. from E. Line

200' Ft. from W. Line

0			

Location

Rig up

Drilling and Remarks:

RECORD

Cased in., ft.

Sand

Gas

Oil

Total Depth

PRODUCTION

1st 24 hrs. Nat.

1st 24 hrs. after shot

Gas Cu. Ft.

Dry Hole

Abandoned

Date

1/2 1919

Pyle

Scout

Map No. K11 Sec. 2 Twp. 29 R. 4Well No. 2 KruegerKansas-Wyoming Company

Contractor

SECTION PLAT

50 Ft. from N. Line

Ft. from S. Line

Ft. from E. Line

200 Ft. from W. LineDup^{icate}

COMPLETED

Location

Rig up

Drilling and Remarks:

RECORD

Cased _____ in., _____ ft.

Sand 3114 - 20

Gas _____

Oil _____

Total Depth _____

PRODUCTION

1st 24 hrs. Nat. 100 bbls

1st 24 hrs. after shot _____

Gas _____ Cu. Ft.

Dry Hole _____

Abandoned _____

Date

6/8 1920

Pyle

Scout

Map No. K11 Sec. 2 Twp. 29 R. 4Well No. 1 KruegerKansas Wyoming Company

Contractor

SECTION PLAT

50' Ft. from N. Line

Ft. from S. Line

Ft. from E. Line

200 Ft. from W. Line

o			

FIRST REPORT

Location

Rig up ☒

Drilling and Remarks:

RECORD

Cased _____ in., _____ ft.

Sand _____

Gas _____

Oil _____

Total Depth _____

PRODUCTION

1st 24 hrs. Nat. _____

1st 24 hrs. after shot _____

Gas _____ Cu. Ft.

Dry Hole _____

Abandoned _____

Date

12/17 1919

Pyle

Scout