


Map No. _____ Sec. 3 Twp. 29 R. 4
 Well No. 15 minor Farm _____
Ohio Oil Co Company

NORTH

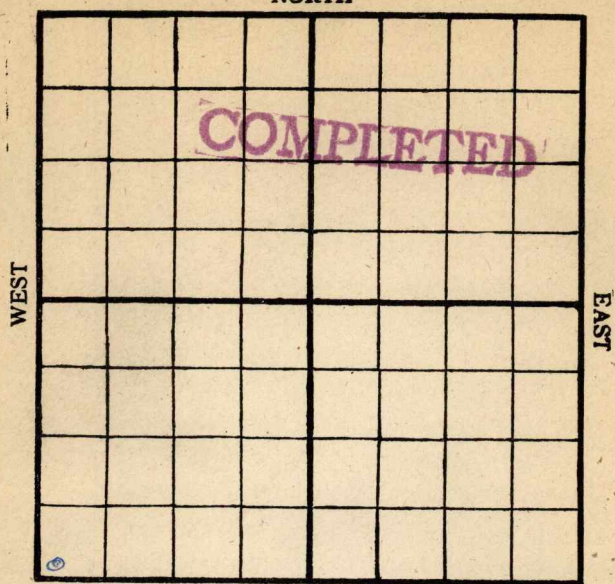

SOUTH

Location _____

Rig Up _____

Drilling Remarks:

Drilling Remarks:

RECORD

PRODUCTION


Cased _____ in. _____ ft.
 Sand _____
 Gas _____
 Oil _____
 Total Depth _____

1st 24 hrs. Nat. _____
 1st 24 hrs. after shot _____
 Gas _____ cu. ft.
 Dry Hole _____
 Abandoned _____

Map No. K11 Sec. 3 Twp. 29 R. 4Well No. 15 24 in FarmOhio Company

NORTH

WEST

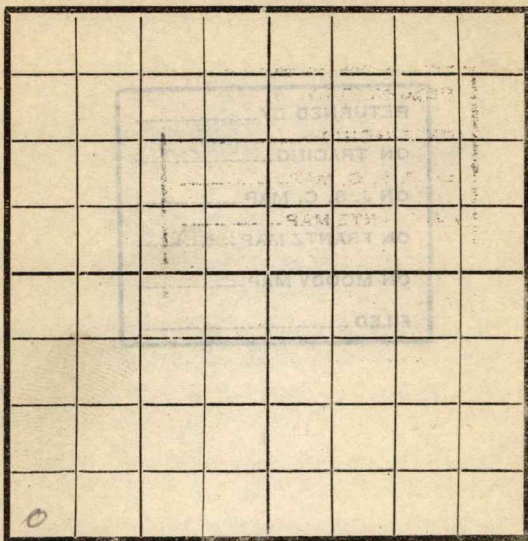

EAST

SOUTH

Location ✓Rig Up ✓

Drilling and remarks

RECORD

Cased in. Ft.Sand Gas Oil Total Depth

PRODUCTION

1st 24 hrs. Nat. 1st 24 hrs. after shot Gas Cu. Ft.Dry Hole Abandoned

FIRST REPORT

Date

5/14, 1918 8 Condy Scout


Map No. _____ Sec. 3 Twp. 29 R. 4Well No. 157 minor Farm _____

Company _____

NORTH

WEST

EAST

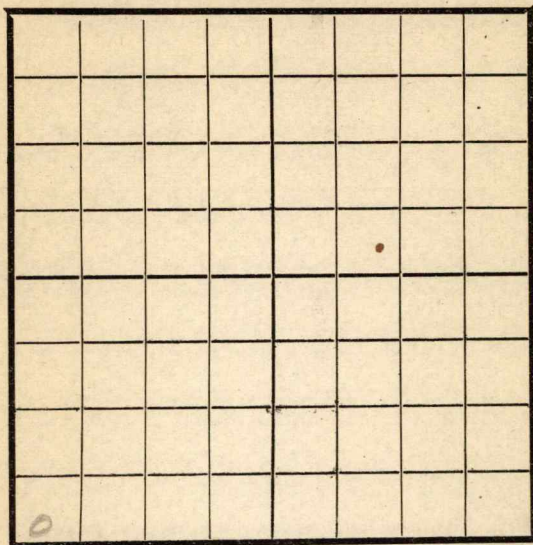

SOUTH

Location _____

Rig Up _____

Drilling and remarks

Spudding
Co. Tools

RECORD

Cased _____ in. _____ Ft.

Sand _____

Gas _____

Oil _____

Total Depth _____

PRODUCTION

1st 24 hrs. Nat. _____

1st 24 hrs. after shot _____

Gas _____ Cu. Ft.

Dry Hole _____

Abandoned _____

Date


5722, 1918 *P. Cordy* Scout

Map No. _____ Sec. 3 Twp. 29 R. 4
Well No. 152 Farm _____
Ohio Company _____

NORTH

WEST

EAST

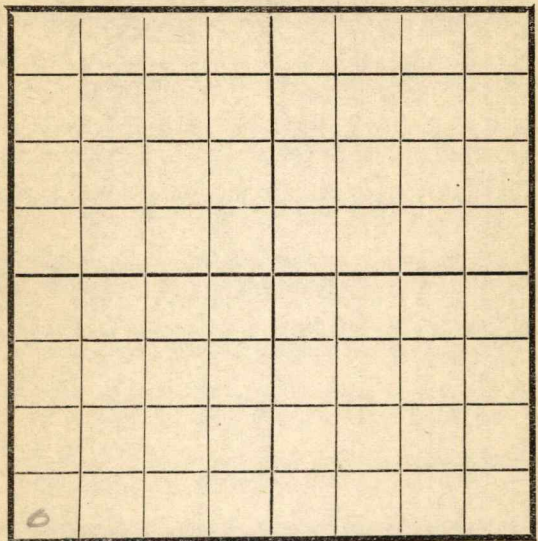

SOUTH

	RECORD
Location _____	Cased _____ in. _____ Ft.
Rig Up _____	Sand _____
Drilling and remarks _____	Gas _____
	Oil _____
	Total Depth _____
	PRODUCTION
	1st 24 hrs. Nat. _____
	1st 24 hrs. after shot _____
	Gas _____ Cu. Ft.
	Dry Hole _____
	Abandoned _____

Date 5/29, 1918 O. Carby Scout

Map No. _____ Sec. 3 Twp. 29 R. 4

Well No. 15 minor
Ohio Company

Contractor

NORTH

WEST

EAST

SOUTH

Location _____

Rig up-----

Drilling and Remarks:

RECORD

Cased-----in., -----ft.

Sand_____

Gas -----

Oil _____

Total Depth_____

PRODUCTION

1st 24 hrs. Nat. -----

1st 24 hrs. after shot.....

Gas.....Cu. Ft.

Dry Hole.....

Abandoned.....

Date _____

6/3-1918 J. Conley Scout


Map No. _____ Sec. 3 Twp. 29 R. 4Well No. 15 minor_____ Ohio _____ Company

_____ Contractor

NORTH

WEST

EAST

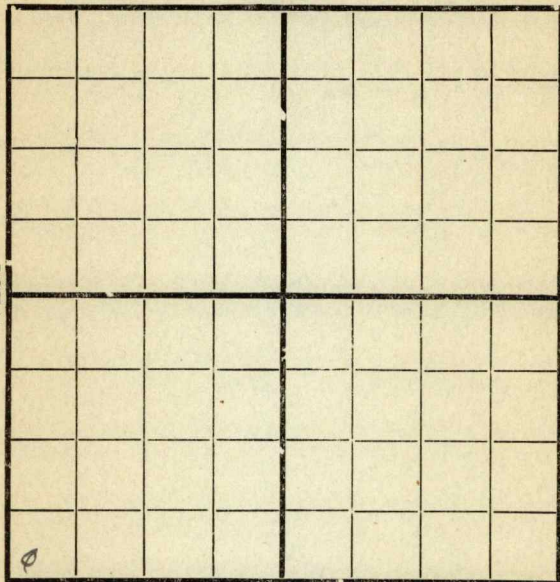

SOUTH

Location _____

Rig up _____

Drilling and Remarks:

16 30**RECORD**

Cased _____ in., _____ ft.

Sand _____

Gas _____

Oil _____

Total Depth _____

PRODUCTION

1st 24 hrs. Nat. _____

1st 24 hrs. after shot _____

Gas _____ Cu. Ft.

Dry Hole _____

Abandoned _____

Date

6/19 1911 S. Conley Scout


Map No. _____ Sec. 3 Twp. 29 R. 4Well No. 157 minor

_____ Company

_____ Contractor

NORTH

WEST

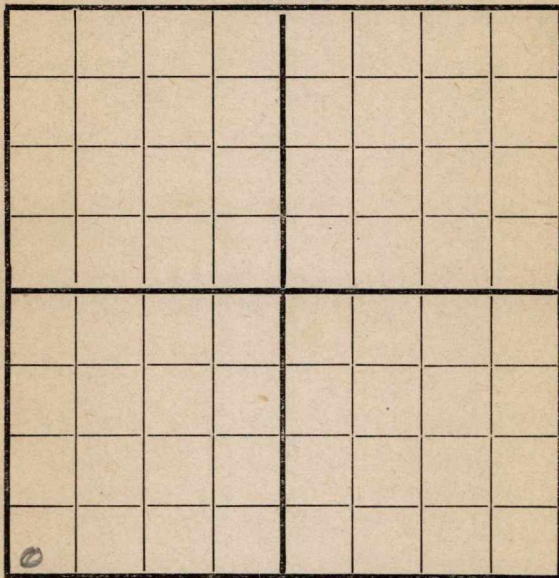

EAST

SOUTH

Location _____

Rig up _____

Drilling and Remarks:

got very light
showing oil
1783-1802-
will drill
deeper

RECORD

Cased _____ in., _____ ft.

Sand 1783-1802

Gas _____

Oil _____

Total Depth _____

PRODUCTION

1st 24 hrs. Nat. _____

1st 24 hrs. after shot _____

Gas _____ Cu. Ft.

Dry Hole _____

Abandoned _____

Date

6/26 1918 E. Canby Scout


Map No. _____ Sec. 3 Twp. 29 R. 4
 Well No. 15 _____
 _____ Company
 _____ Contractor

NORTH							
WEST							
SOUTH							
EAST							

Location _____ Rig up _____ Drilling and Remarks: <u>1950</u>	RECORD Cased _____ in., _____ ft. Sand _____ Gas _____ Oil _____ Total Depth _____ PRODUCTION 1st 24 hrs. Nat. _____ 1st 24 hrs. after shot _____ Gas _____ Cu. Ft. Dry Hole _____ Abandoned _____
--	---

Date 7/3 191 J. C. Cardy Scout

Map No. _____ Sec. 3 Twp. 29 R. 4
Well No. 15 minor
_____ Company _____
_____ Contractor _____

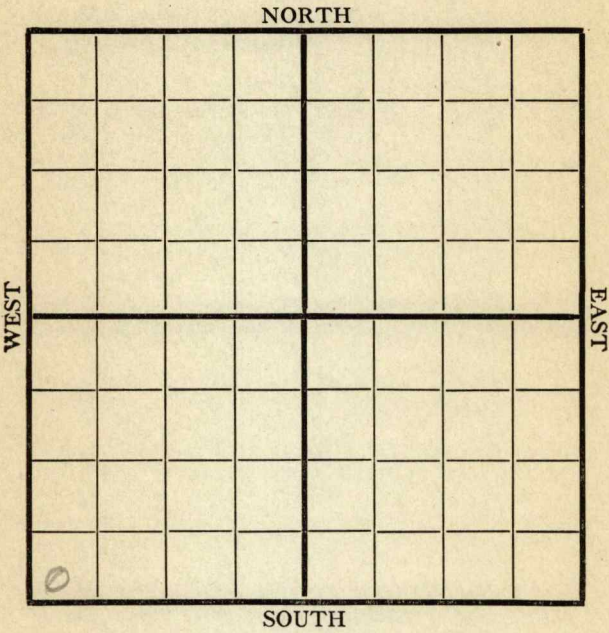

Location _____ Rig up _____ Drilling and Remarks: <u>2230</u>	RECORD
	Cased _____ in., _____ ft.
	Sand _____
	Gas _____
	Oil _____
	Total Depth _____
	PRODUCTION
	1st 24 hrs. Nat. _____
	1st 24 hrs. after shot _____
	Gas _____ Cu. Ft.
	Dry Hole _____
	Abandoned _____

Date 7/10 191 S. C. Lindsey Scout

Map No. _____ Sec. 3 Twp. 29 R. 4
 Well No. 152
Oliver Company
 Contractor

NORTH								
WEST								EAST
SOUTH								

Location _____

Rig up _____

Drilling and Remarks:

*Straight
 Running
 2365*

RECORD

Cased _____ in., _____ ft.

Sand _____

Gas _____

Oil _____

Total Depth _____

PRODUCTION

1st 24 hrs. Nat. _____

1st 24 hrs. after shot _____

Gas _____ Cu. Ft.

Dry Hole _____

Abandoned _____

Date

7/17 1918 S. Conley Scout


Map No. _____ Sec. 3 Twp. 29 R. 4Well No. 15 minor
Olin _____ Company

Contractor _____

NORTH

WEST

EAST

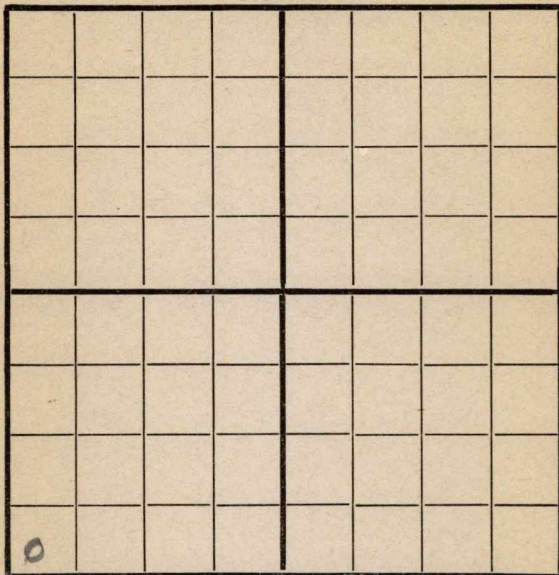

SOUTH

Location _____

Rig up _____

Drilling and Remarks:

2375

RECORD

Cased _____ in., _____ ft.

Sand _____

Gas _____

Oil _____

Total Depth _____

PRODUCTION

1st 24 hrs. Nat. _____

1st 24 hrs. after shot _____

Gas _____ Cu. Ft.

Dry Hole _____

Abandoned _____

Date

7/24

191

J. Cordery

Scout

Map No. _____ Sec. 3 Twp. 29 R. 4Well No. 15 minorOhio


Company _____

Contractor _____

NORTH

WEST

EAST

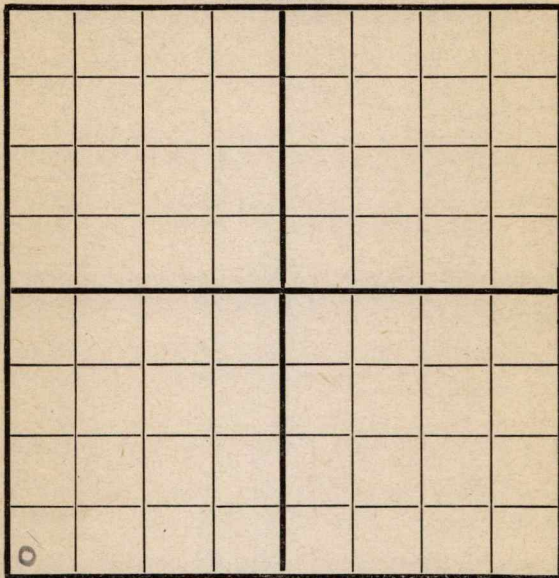

SOUTH

200 ~~4~~ 5 x 200 ~~8~~ W Line

RECORD

Location _____

Cased _____ in., _____ ft.

Rig up _____

Sand _____

Drilling and Remarks:

Gas _____

Oil _____

Total Depth _____

PRODUCTION

1st 24 hrs. Nat. _____

1st 24 hrs. after shot _____

Gas _____ Cu. Ft.

Dry Hole _____

Abandoned _____

2580

Date

7/31

191

J. C. Conley


Scout

Map No. _____ Sec. 3 Twp. 29 R. 4
 Well No. 15 minor
Ohio _____ Company _____
 _____ Contractor _____

NORTH

WEST

EAST

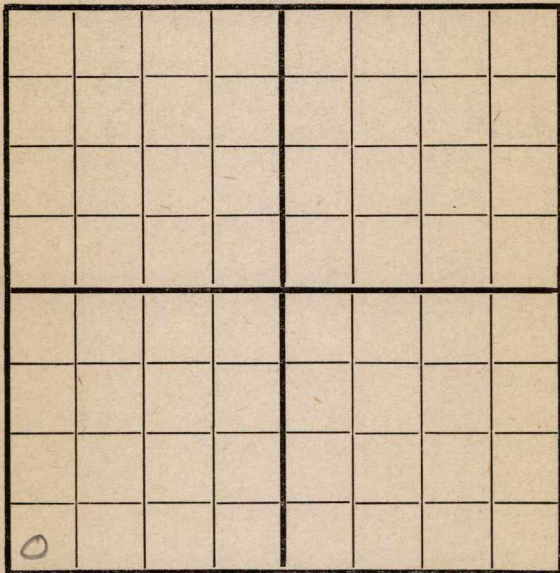

SOUTH

200 S & W

Location _____

Rig up _____

Drilling and Remarks:

2780

RECORD

Cased _____ in., _____ ft.

Sand _____

Gas _____

Oil _____

Total Depth _____

PRODUCTION

1st 24 hrs. Nat. _____

1st 24 hrs. after shot _____

Gas _____ Cu. Ft.

Dry Hole _____

Abandoned _____

Date

8/7

191

J. C. Condy

Scout

Map No. _____ Sec. 3 Twp. 29 R. 4Well No. 15 mineOhio


Company _____

Contractor _____

NORTH

WEST

EAST

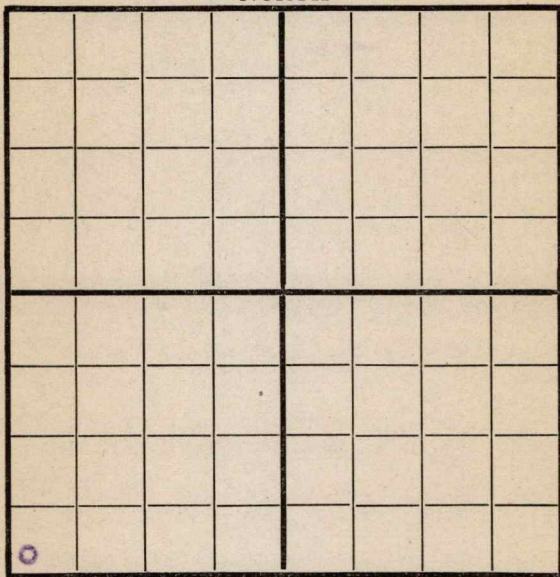

SOUTH

20020W

RECORD

Location 1320

Cased _____ in., _____ ft.

Rig up _____

Sand _____

Drilling and Remarks:

Gas _____

Oil _____

Total Depth _____

2915

PRODUCTION

1st 24 hrs. Nat. _____

1st 24 hrs. after shot _____

Gas _____ Cu. Ft.

Dry Hole _____

Abandoned _____

Date

8/14 1918Quincy

Scout

Butler
 K11
 MAP NO. KANSAS SEC. 3 TWP. 29S 4E
 WELL NO. 15 *Merino*
Mid-Kansas COMPANY

CONTRACTOR

SECTION PLAT

0			

FT. FROM N. LINE

FT. FROM S. LINE

FT. FROM E. LINE

FT. FROM W. LINE

ABANDONED

LOCATION

RIG UP

DRILLING AND REMARKS:

RECORD

CASED IN. FT.

SAND

GAS

OIL

TOTAL DEPTH 2930

PRODUCTION

1ST 24 HRS. NAT.

1ST 24 HRS. AFTER SHOT

GAS Cu. Ft.

DRY HOLE ☒

ABANDONED ☒

DATE

8/21 1928

SCOUT

Map No. K11 Sec. 3 Twp. 29 R. 4Well No. 15 minorOhio CompanyCompany Tool Contractor

NORTH

WEST

COMPLETED

EAST

SOUTH

200' S - 200' W

RECORD

Location _____

Cased _____ in., _____ ft.

Rig up _____

Sand _____

Drilling and Remarks:

Gas _____

Oil _____

Total Depth 2930

PRODUCTION

1st 24 hrs. Nat. _____

1st 24 hrs. after shot _____

Gas _____ Cu. Ft.

Dry Hole _____

Abandoned _____

Date

8/21/18Candy

191

Scout