


KANSAS Barton

FORM 51 5M PETROL

Section 21 Township 16 Range 11W

Well No. 2 Seyfert

Company Anderson & Prichard

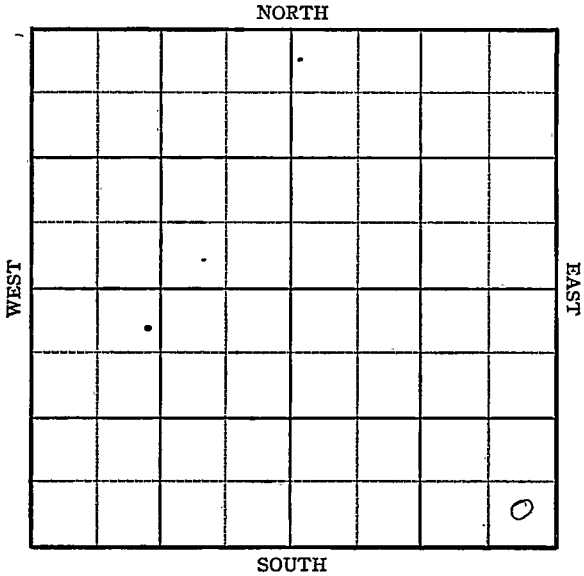

KANSAS

Barton

Sec. 21 Twp. 16 R. 11-W

Well No. #2 Seyfert Farm


Anderson & Prichard Company

 Ft. from N. Line

330 Ft. from S. Line

330 Ft. from E. Line

 Ft. from W. Line

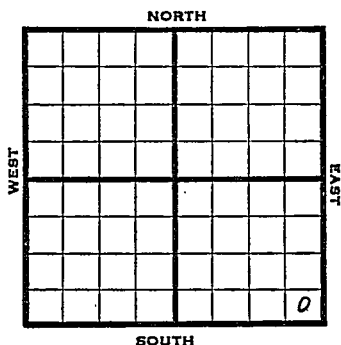

SE/c

1945 Elev. 1921 REPORT

9/26 8" @ 190' WBC

10/3 Anhy. 745

Drlg. 2435

10/17 5" @ 3339

3000' oil fsg.

10/24 Arb. 3338

5" @ 3339

TD 3345'

Echo Pot. 2505

Grav. 42.0

COMPLETED

KANSAS

Kansas


Pool Name Kraft-PrusaMap No. 55 Sec. 21 Twp. 16 R. 11WWell No. 2 SevfertAnderson & Prichard Company

FIRST REPORT

Contractor

SE/c

SECTION PLAT

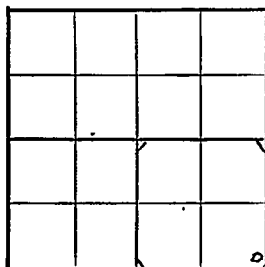 Ft. from N. Line330 Ft. from S. Line330 Ft. from E. Line Ft. from W. LineBarton CountyLocationRig upDrilling and Remarks:8"-190 WOC

RECORD

Cased in., ft.Sand Gas Oil Total Depth

PRODUCTION

1st 24 hrs. Nat. 1st 24 hrs. after shot Gas Cu. Ft.Dry Hole Abandoned

Date

SEP 26 194519S. J. LEWISScout

KANSAS

Kansas


Pool Name Kraft-PrusaMap No. 55 Sec. 21 Twp. 16 R. 11WWell No. 2 SeyfertAnderson & Prichard

Company

COMPLETED

Contractor

SE/c

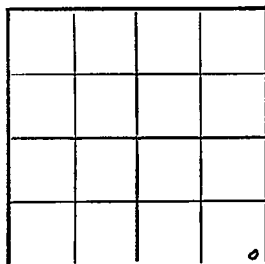E 1, 1921
SECTION PLAT Ft. from N. Line330 Ft. from S. Line330 Ft. from E. Line Ft. from W. Line

Barton County

Location Rig up

Drilling and Remarks:

Cor 33355' 3339Echd Rd 350542° 34'

RECORD

Cased in., ft.Sand Gas Oil Total Depth 3345

PRODUCTION

1st 24 hrs. Nat. 1st 24 hrs. after shot Gas Cu. Ft.Dry Hole Abandoned

Date

OCT 24 1945

19

S. J. LEWIS

Scout