

KANSAS


Form 51—5M—11-38—Palace

Barton

Section 21 Township 16 Range 11-W

Well No. 2 Seyfert

Company Sinclair-Prairie et al

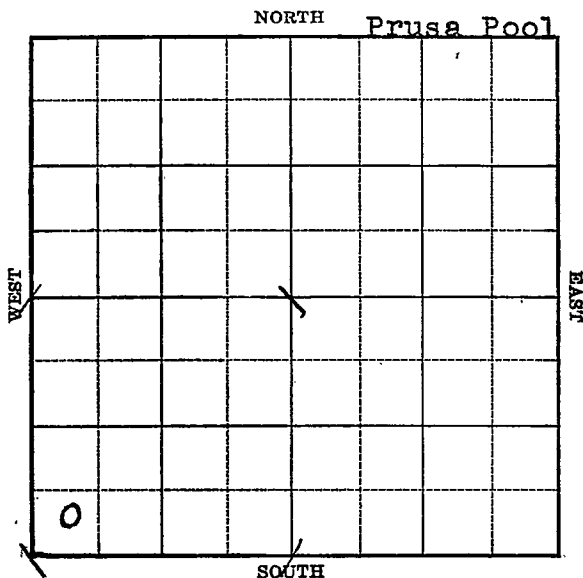

Map No. 55 Sec. 21 Twp. 16 R. 11WWell No. 2 SeyfertSinclair Prairie etal Company

Contractor

FIRST REPORT
SW/C**SECTION PLAT**

drill	site	covers
NE	29	
NW	28	
SW	21	

 Ft. from N. Line440 Ft. from S. Line Ft. from E. Line440 Ft. from W. Line**PRUSA POOL**Location Rig up Drilling and Remarks:
BRR**RECORD**Cased in., ft.Sand Gas Oil Total Depth **PRODUCTION**1st 24 hrs. Nat. 1st 24 hrs. after shot Gas Cu. Ft.Dry Hole Abandoned

Date

FEB 15 1939 19 H. D. Hatfield Scout

Barton

KANSAS

Map No. 55 Sec. 21 Twp. 16 R. 11WWell No. 2 SeyfertSinclair Prairie etal Company

Contractor

COMPLETED

SW/C

SECTION PLAT

0			

 Ft. from N. Line440 Ft. from S. Line Ft. from E. Line440 Ft. from W. Line

PRUSA POOL

Location Rig up Drilling and Remarks: 2000 AcidP-37 oil in 3 hrsTemp Pot110

RECORD

Cased 7 in., 3337 ft.Sand Arb 3337Gas Oil Total Depth 3352

PRODUCTION

1st 24 hrs. Nat. 1st 24 hrs. after shot Gas Cu. Ft.Dry Hole Abandoned

Date

MAR 22 1939 19H. D. Hatfield

Scout