

Sec.

Twp.

R

Farm

Company

NORTH

WEST

EAST

SOUTH

TWIN WELL

Location

Drilling Remarks

Rig Up.

Drilling Remarks

RECORD

Cased _____ in. _____ ft.

Sand

Gas

Oil_____

Total Depth.....

PRODUCTION

1st 24 hrs. Nat.-----

1st 24 hrs. after shot_____

Gas _____ cu. ft. _____

Dry Hole

Abandoned

Butler

Map No. **KANSAS** Sec. 4 Twp. 29 R. 4E


Well No. #2 Klaye Farm
Hodge et al. Company

790 Ft. from N. Line

_____ Ft. from S. Line

450 Ft. from E. Line

_____ Ft. from W. Line

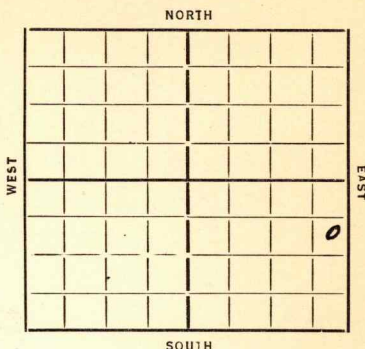

Date 7/25

REPORT

2/27	Machine	
3/7	Rgn	
3/14	slg 210	12" 40
3/21	" 1160	10" 600
3/28	slg 1460	8" 1378
4/4	" 1710	6" 1611
4/11	6" 1745 T 1749 WOC	
4/18	5" 1767 WOC	
4/24	slg 1835	5 1767
5/1	T 1895	12.5 FT.

ABANDONED

KANSAS

Map No. 11 Sec. 4 Twp. 29 R. 4 E

Well No. 2-Blaze

Hodge et al Company

Contractor

FIRST REPORTS

SE

SECTION PLAT

790 Ft. from N. Line

..... Ft. from S. Line

450 Ft. from E. Line

..... Ft. from W. Line

Twin well

Location.....

Rig up.....

Drilling and Remarks:

Machine

RECORD

Cased..... in., ft.

Sand.....

Gas.....

Oil.....

Total Depth.....

PRODUCTION

1st 24 hrs. Nat.....

1st 24 hrs. after shot.....

Gas..... Cu. Ft.

Dry Hole.....

Abandoned.....

Date

2-27-35 192.....

ORVAL MANNSCHRECK

Scout

KANSAS

Map No. 11 Sec. 4 Twp. 29 R. 4 EWell No. 2-KeazeHodge et al Company

Contractor

ABANDONED

SECTION PLAT

			0

790 Ft. from N. Line

Ft. from S. Line

450 Ft. from E. Line

Ft. from W. Line

Location

Rig up

Drilling and Remarks:

RECORD

Cased.....in.,ft.

Sand.....

Gas.....

Oil.....

Total Depth 1895

PRODUCTION

1st 24 hrs. Nat.....

1st 24 hrs. after shot.....

Gas.....Cu. Ft.

Dry Hole.....

Abandoned.....

Date

5-1-35 192

ORVAL MANNSCHRECK Scout