


Map No. _____ Sec. 4 Twp. 29 R. 4

Well No. 10. Minor Farm _____

Ohio

Company

NORTH

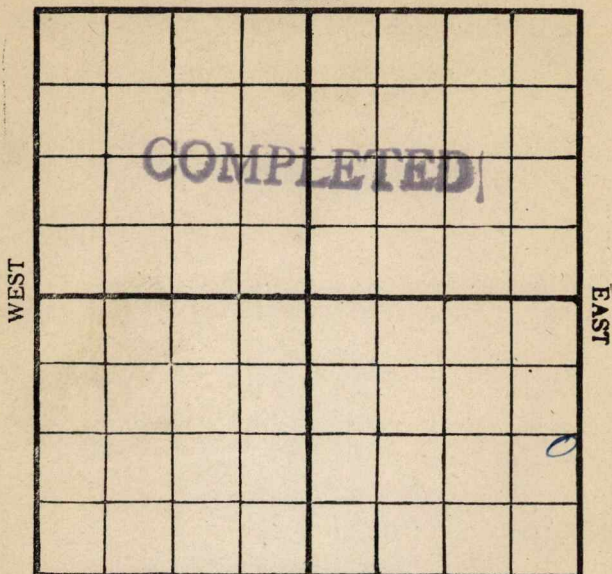

SOUTH

Location -----

Drilling Remarks:

Rig Up-----

Drilling Remarks:

RECORD

Cased----- in.-----ft.

Sand -----

Gas _____

Oil _____

Total Depth_____

PRODUCTION

1st 24 hrs. Nat.-----

1st 24 hrs. after shot-----

Gas_____cu. ft


Dry Hole_____

Abandoned -----

Map No. K11 Sec. 4, Twp. 29, R. 4Well No. 10 minorOhio Company

NORTH

WEST

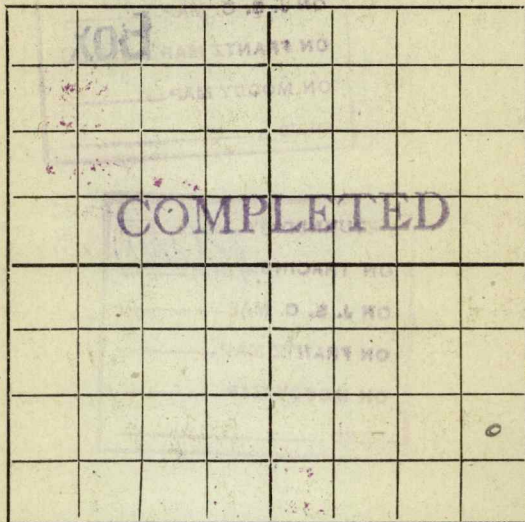

EAST

SOUTH

Location -----

Rig up -----

Drilling and remarks:

Est at300 R66

RECORD

Cased ----- in., ----- Ft.

Sand 1788-1795

Gas -----

Oil -----

Total Depth -----

PRODUCTION

1st 24 hrs. Nat. -----

1st 24 hrs. after shot -----

Gas ----- Cu. ft.

Dry Hole -----

Abandoned -----

Date

9/51917Condy

Scout

Map No. _____ Sec. 4 Twp. 29 R. 4


Well No. 10. Minor Farm _____

Ohio Company _____

NORTH

WEST

EAST

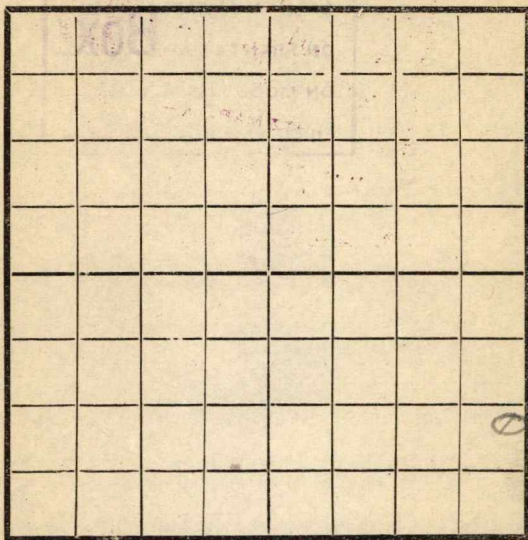

SOUTH

Location _____

Rig Up _____

Drilling and remarks

at 1150.

RECORD

Cased _____ in. _____ Ft.

Sand _____

Gas _____

Oil _____

Total Depth _____

PRODUCTION

1st 24 hrs. Nat. _____

1st 24 hrs. after shot _____

Gas _____ Cu. Ft.

Dry Hole _____

Abandoned _____

Date

8-20, 1917

Lantz

Scout