

KANSAS


Butler

FORM 51 25M 3-49 PETROL

Section 6 Township 29 Range 4-E

Well No. #1 Darter "A"

Company Greeley Drlg.

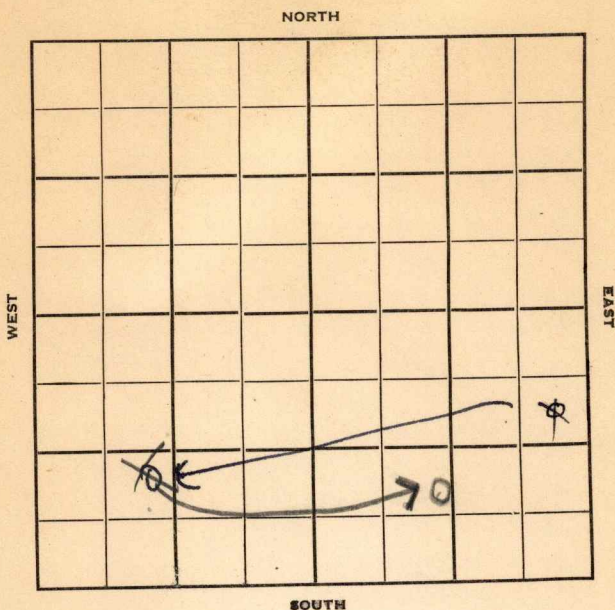

Sec. 6 Twp. 29 R. 4E

Well No. #1 Darter "A" Farm ☒

Greeley Drlg. Company

Contractor

Miscellaneous


990' Ft. from N. Line

750 Ft. from S. Line

+830 <sup>1430</sup> Ft. from E. Line

\_\_\_\_\_ Ft. from W. Line

~~SE NE SE~~  
~~NE SW SW SE~~

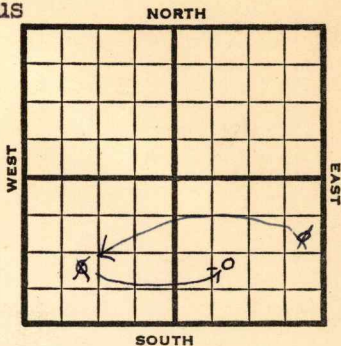

1950

**Elev 1288** REPORT

9/20

Spud 9-13-50  
8" @ 72'  
Drlg. 1268'

10/25

8" @ 72  
**Arb 2587**  
TD 2774  
5" @ 2774  
Perf @ 2719 SO & water  
SP 2657  
Perf 2647 SO & water PB 2660  
Perf 2615 2641 & 2657 S/2 boph 2/2648  
Comp 35 bopd  
Completed

**COMPLETED**

County

Butler

State

## Kansas

Sec.

2

( Blk. )  
( Twp. )

29

(Sur.)  
(Rge.)

45

Map No.

Operator

Greeley Drlg.

Well No. \_\_\_\_\_

3

Farm

Darter "A"

Elev.

### Location

SE NE SE

0

990 Ft. From

N Line

SE

330 Ft. From

### E Line

Quarter

### 1st. Report

SEP 20 1950

## Completion

Remarks

Spudding Date

9-13-50

### Drlg. Data

Miscellaneous

8<sup>th</sup> @ 72

drlg. 1268

J. E. TYRA

Kansas

Map No. \_\_\_\_\_ Sec. 6 Twp. 29 R. 4EWell No. 1 Darter "A"Greeley Drlg. CompanyCORRECTION Contractor

NE SW SW

## SECTION PLAT

|   |  |  |  |
|---|--|--|--|
|   |  |  |  |
|   |  |  |  |
|   |  |  |  |
|   |  |  |  |
| 0 |  |  |  |

\_\_\_\_\_ Ft. from N. Line

750 Ft. from S. Line1830 Ft. from E. Line

\_\_\_\_\_ Ft. from W. Line

Butler County

Location \_\_\_\_\_

Rig up \_\_\_\_\_

Drilling and Remarks:

Reported

SE NE SE

## RECORD

Cased \_\_\_\_\_ in., \_\_\_\_\_ ft.

Sand \_\_\_\_\_

Gas \_\_\_\_\_

Oil \_\_\_\_\_

Total Depth \_\_\_\_\_

## PRODUCTION

1st 24 hrs. Nat. \_\_\_\_\_

1st 24 hrs. after shot \_\_\_\_\_

Gas \_\_\_\_\_ Cu. Ft.

Dry Hole \_\_\_\_\_


Abandoned \_\_\_\_\_

Date

OCT 4 1950 19J. E. TYRA Scout



County Butler State Kansas  
 Sec. 6 (Blk.) 29 (Sur.) 4E Map No. (Twp.)  
 Operator Greeley Drlg.  
 Well No. 1 Farm Darter "A"  
 Elev. 1288 Location NE SW SE

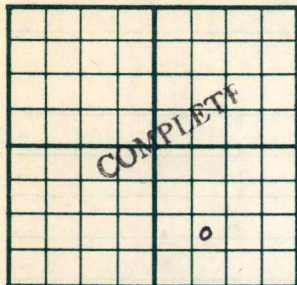

750 Ft. From S Line SE  
1430 Ft. From E Line Quarter  
 1st. Report  
 Completion OCT 25 1950  
 Remarks  
 Spudding Date 9-13-50

Drlg. Data Oil well TD 2774  
8" @ 72 Arb. 2587 TD 2774 5" @ 2774  
Perf @ 2719 SO & water SP 2657 Perf.  
2647 SO & water PB 2660 Perf. 2615  
2641 & 2657 S/ 2 boph 2/ 2648  
Comp. 35 bopd

J. E. TYRA

Laughlin - Simmons  
has sent a second  
correction changing  
this back to the SF/4

mae

Map No. \_\_\_\_\_ Sec. 6 Twp. 29 R. 4EWell No. 1 Darter "A"Greeley Drlg.

Company \_\_\_\_\_

**CORRECTION**

Contractor \_\_\_\_\_


NE SW SE

**SECTION PLAT**

\_\_\_\_\_ Ft. from N. Line

750 Ft. from S. Line1430 Ft. from E. Line

\_\_\_\_\_ Ft. from W. Line

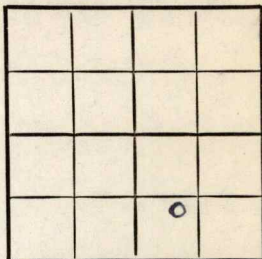Butler County

Location \_\_\_\_\_

Rig up \_\_\_\_\_

Drilling and Remarks:

Reported SE NE SE

Corrected to

NE SW ~~SW~~ SESB**RECORD**

Cased \_\_\_\_\_ in., \_\_\_\_\_ ft.

Sand \_\_\_\_\_

Gas \_\_\_\_\_

Oil \_\_\_\_\_

Total Depth \_\_\_\_\_

**PRODUCTION**

1st 24 hrs. Nat. \_\_\_\_\_

1st 24 hrs. after shot \_\_\_\_\_

Gas \_\_\_\_\_ Cu. Ft.

Dry Hole \_\_\_\_\_

Abandoned \_\_\_\_\_

Date

OCT 1 8 1950 19J. E. TYRA

Scout