

Sec. 6 Twp. 29 R. 4E

Well No. 1 Mann Farm

Rex & Morris Company

Rex & Morris Contractor

Douglas Pool


_____ Ft. from N. Line

330 Ft. from S. Line

_____ Ft. from E. Line

990 Ft. from W. Line

SE SW SE

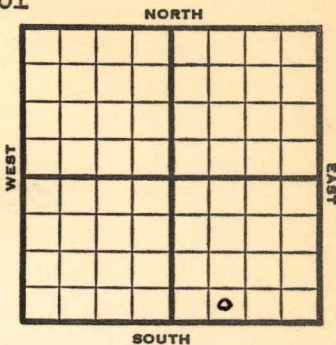

1953

Elev. 1284' REPORT

4/15

Cellar & Pits.

5/13

Spud 4-19-53 Oil well TD 3172
 8" @ 156 Lens. 1800 KC 2130
 B KC 2320 Arb. 2580 Gr. wash 3157
 Granite 3171' TD 3172 5" @ 2742
 10/2674-77 13/2660-64 1/3 BWPH
 PB 2655 32/2640-52 1000 A 10 BO
 100 BWPD PB 2600 10/2580-83
 FU 900' oil 16 hr.
 Comp. 35 BOPD

COMPLETED

