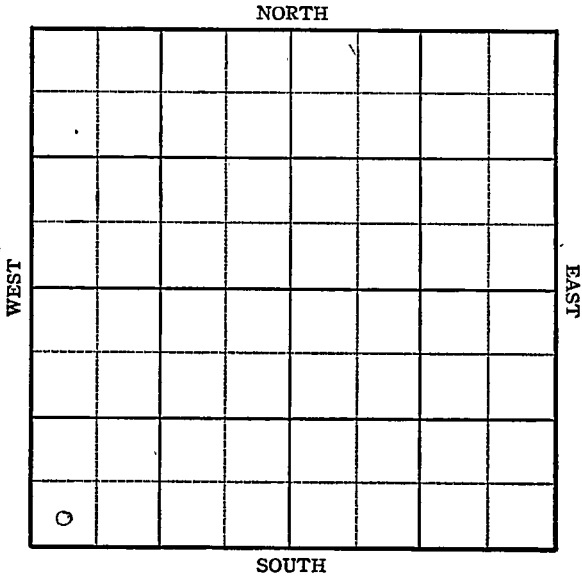


KANSAS


Barton

FORM 51 5M PETROL

Section 22 Township 16 Range 11WWell No. 2 Desthorn.Company Gulf

Sec. 22 Twp. 16 R. 11-WWell No. #2 Desthorn FarmGulf Company Ft. from N. Line330 Ft. from S. Line Ft. from E. Line330 Ft. from W. Line

Syc

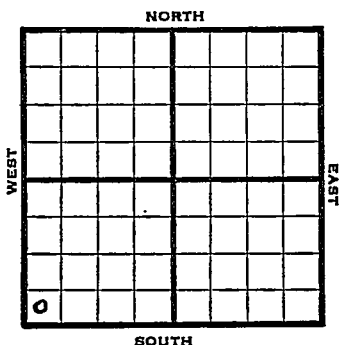

1945 Elev. 1921' REPORT

11/28 Location

12/5 8" @ 549 WOC

12/12 Drlg. 3266'

12/20 B.K.C. 3337' Arb. 3342'

T.D. 3348' 5" - 3343' Swab 31 oil
1 hour.

12/29 " "

1946 " "

1/10 " "

1/17 " "

1/24 " "

1/31 " "

2/6 2000 acid. Pump 99 oil in 7½ hours.

2/13 Arb. 3342

5" @ 3343

2000 acid.

TD 3348'

Depth Pot. 1455

Grav. 42.6

COMPLETED

KANSAS Kansas Pool Name Kraft-Prusa

Map No. 55 Sec. 22 Twp. 16 R. 11WWell No. 2 Desthorn

Gulf

Company

FIRST REPORT

Contractor

SW/c

SECTION PLAT

Ft. from N. Line

330

Ft. from S. Line

Ft. from E. Line

330

Ft. from W. Line

Barlow
Kraft-PrusLocation X

Rig up

Drilling and Remarks:

RECORD

Cased _____ in., _____ ft.

Sand _____

Gas _____

Oil _____

Total Depth _____

PRODUCTION

1st 24 hrs. Nat. _____

1st 24 hrs. after shot _____

Gas _____ Cu. Ft.

Dry Hole _____

Abandoned _____

Date

NOV 28 1945

19

S. J. LEWIS

Scout

KANSAS / Kansas Pool Name Kraft-PrusaMap No. 22 Sec. 22 Twp. 16 R. 11WWell No. 2 DesthornGulf

Company

COMPLETED

Contractor

SW/c

E1.1921
SECTION PLAT Ft. from N. Line330 Ft. from S. Line Ft. from E. Line330 Ft. from W. Line

Barton County

Location Rig up

Drilling and Remarks:

Art 3342
5" @ 3343
2000 acid
Sept 1st 1455

*42 1/2***RECORD**Cased in., ft.Sand Gas Oil Total Depth 3345**PRODUCTION**1st 24 hrs. Nat. 1st 24 hrs. after shot Gas Cu. Ft.Dry Hole Abandoned

Date

FEB 13 1946

19

S. J. LEWIS

Scout