


Sedgwick

KANSAS

SECTION 7 TOWNSHIP 29 RANGE 2 E

WELL NO. #1 Ainsworth

COMPANY J. P. Gaty

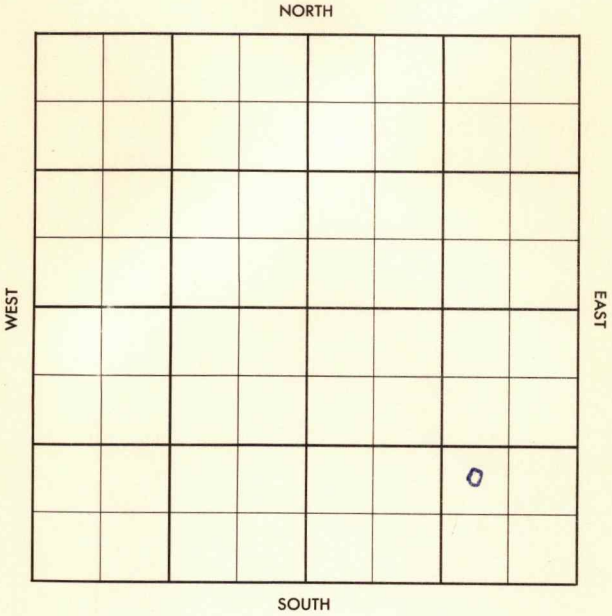

Sedgwick

KANSAS

SEC.	TWP.	R.
7	29	2E

WELL NO.

#1 Ainsworth

FARM

COMPANY

J.P. Gaty

CONTRACTOR

Laura Jane

WILDCAT


_____ Ft. from N. Line

_____ Ft. from S. Line

_____ Ft. from E. Line

_____ Ft. from W. Line

NW SE SE

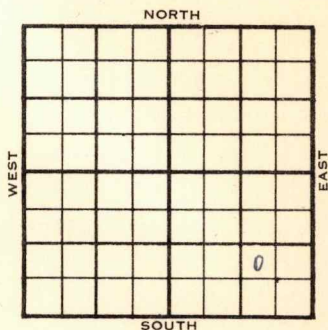

	ELEVATION	REPORT
1956	1303 NB	

1-18 Comm. 1-10-56
8" @ 120/150
DST 2266-89 op 15 min. rec. 290' sw.
Stal. 2266
KC 2593

3-14 5½" @ 3488
DD 3503
D & A
Marm 2817
M. 3088
S. 3467
A 3501
TD 3488'

ABANDONED

County Sedgwick Elev. _____
 Sec. 7 Twp. 29 Rge. 2E
 Company J. P. Gaty
 Farm Name Ainsworth No. 1

TOPS	DEPTH	LOG	DATUM	Loc. in Sec.
Anh.				NW SE SE
Tp.				
H.				
Tr. <u>Stal.</u>	<u>2266</u>			
Dg.				
BL.				
L.				Geol. _____
K.C.	<u>2593</u>			Contr. _____
B.K.C.				<u>Laura Jane</u>
Ce.				Pool _____
C.				<u>Wildcat</u>
M.				JAN 16 - 56 FIRST REPORT
M.				
K.				
Mz.				
Mq.				
V.				
S.				
S.				
A.				
R.				
Pe.				
G.				
T.D.				

Date Comm. 1-10-56
8" @ 102/150 DST 2266-80 open 15 min.
rec. 290' sw

County Sedgwick Elev. 1303 KB
 Sec. 7 Twp. 29 Rge. 2E
 Company J. P. Gaty
 Farm Name Ainsworth No. 1

TOPS	DEPTH	LOG	DATUM	Loc. in Sec.
Anh.				NW SE SE
Tr.				
Dg.				
Bl.				
L.				
K.C.	<u>2593</u>		<u>1290</u>	Geol.
B.K.C.				Contr.
Ce. <u>Marm</u>	<u>2817</u>		<u>1514</u>	Laura Jane
C.	<u>3088</u>		<u>1785</u>	Pool
M.				Wildcat
M.				
K.				
Mz.				
Mq.				
V.				
S.	<u>3467</u>		<u>2164</u>	
S.				
A.	<u>3501</u>		<u>2198</u>	
R.				
Pe.				
G.				
T.D.	<u>3488</u>			



Date Comm. 1-10-56 MAR 14 1956
8" @ 102/150 DST 2266-80 open 15 min.
rec. 290' SW 5 1/2" @ 3488 DD 3503

D & A