


Section 10 Township 29 Range 2 E

Well No. # 1 Kraebiel

Company E. H. Adair

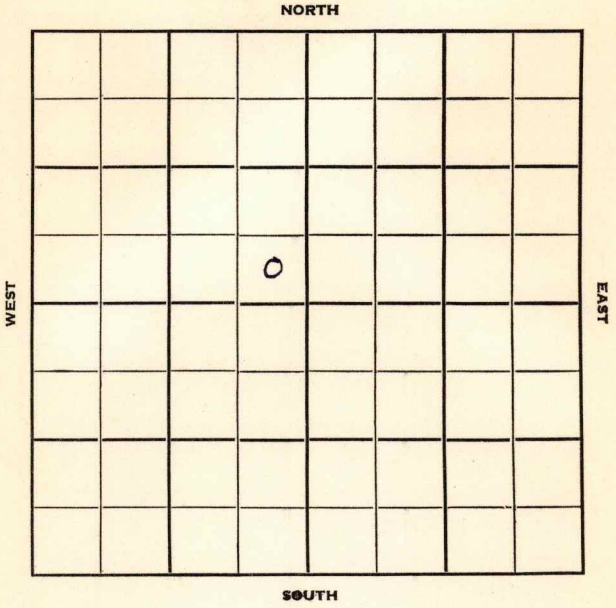

Sedgwick

KANSAS

Sec. 10 Twp. 29 R. 2E

Well No. #1 Kraebiel Farm

E. H. Adair Company

Adair- Contr. Contractor

Wildcat

Ft. from N. Line

330'


Ft. from S. Line

330'

Ft. from E. Line

Ft. from W. Line

SE SE NW

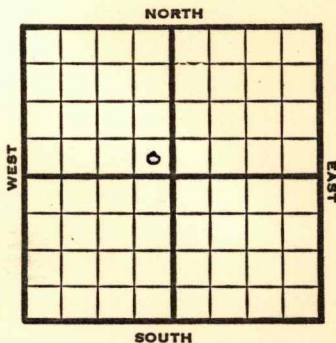

1951

Elev. 1353'

REPORT

5/23

RUR

6/13

Spud 5-25-51


D&A TD 3410

8" @ 100

Lans. 2585 Miss 3078

TD 3410 D&A

ABANDONED

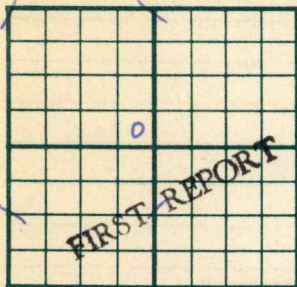County Sedgwick State KansasSec. 10 (Blk. Twp.) 29 (Sur. Rge.) 2E Map No.Operator E. H. AdairWell No. 1 Farm KraebielElev. Location SE SE NW330 Ft. From S Line NW330 Ft. From E Line Quarter1st. Report MAY 23 1951

Completion


Remarks

Adair - Contr.

Spudding Date

Drlg. Data WildcatRUR

J. E. TYRA

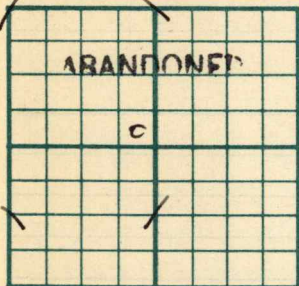County Sedgwick State KansasSec. 10 (Bk.
Twp.) 29 (Sur.
Rge.) 2E Map No.Operator E. H. AdairWell No. 1 Farm KraebielElev. 1353 Location SE SE NW330 Ft. From S Line NW330 Ft. From E Line Quarter

1st. Report

Completion JUN 13 1951Remarks WildcatAdair - Contr.Spudding Date 5-25-51Drig. Data D & A TD 34108" @ 100 Lans. 2585 Miss. 3078TD 3410 D & A

J. E. TYRA