
FORM 51 10M 8-47 KANSAS Barton

Section 22 Township 16 Range 11W

Well No. #1 Sulc

Company Westgate-Greenland

Kraft-Prusa

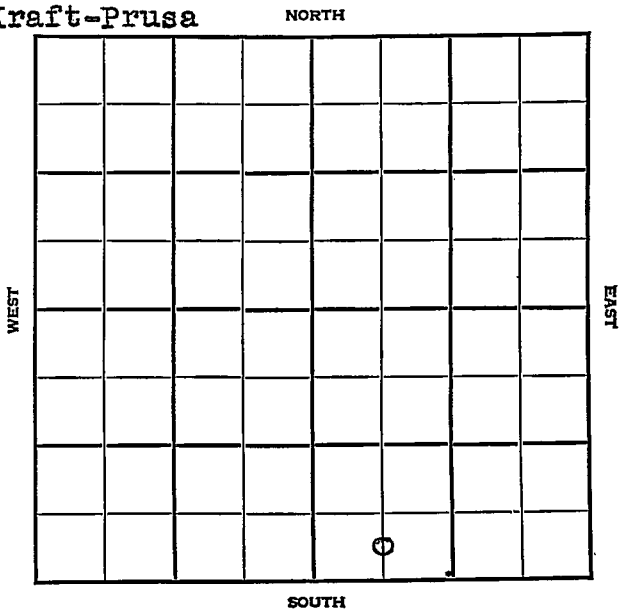

FORM 252-A
5M 9-47 PETROL


KANSAS Barton

Sec. 22 Twp. 16 R. 11W

Well No. #1 Sulc Farm

Westgate-Greenland Company

Kraft-Prusa

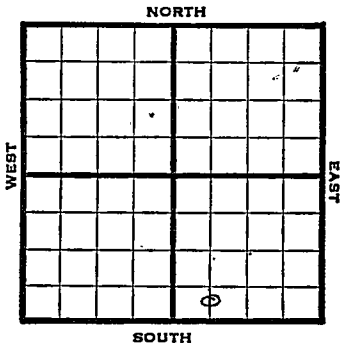

____ Ft. from N. Line

330 Ft. from S. Line

____ Ft. from E. Line

660 Ft. from W. Line

C S L SW SE

1947	Elev. 1911' REPORT
10/15	8"-@ 217' Anhy. 730' Drlg. 1970'
10/22	Lansing 3090' Arbuckle 3389' Total Depth 3423' **ABANDONED**

Form 26 200 Bks. 10-46 Petrol

Kraft-Prusa

Kansas

Map No. Sec. 22 Twp. 16 R. 11W


Well No. 1 Sulc

Westgate-Greenland Company

FIRST REPORT Contractor

C S L SW SE

SECTION PLAT

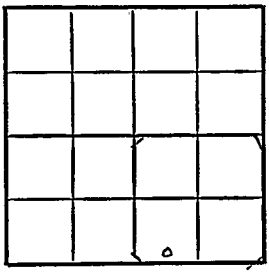

Ft. from N. Line

330 Ft. from S. Line

Ft. from E. Line

660 Ft. from W. Line

Barton County

Location

Rig up

Drilling and Remarks:

8".@ 217

anhy 730

drlg. 1970

RECORD

Cased in., ft.

Sand

Gas

Oil

Total Depth

PRODUCTION

1st 24 hrs. Nat.

1st 24 hrs. after shot

Gas Cu. Ft.

Dry Hole

Abandoned

Date

OCT 15 1947 19

S. J. LEWIS Scout

Form 26 200 Bks. 10-46 Petrol

Kansas

Kraft-Prusa Pool

Map No. 55 Sec. 22 Twp. 16 R. 11W

Well No. 1 Sulc


Westgate-Greenland etal Company

ABANDONED Contractor

C S L SW SE

E.1.1948

SECTION PLAT

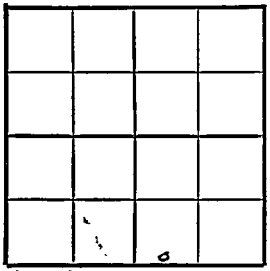

____ Ft. from N. Line

330 Ft. from S. Line

____ Ft. from E. Line

660 Ft. from W. Line

Barton County

Location

Rig up

Drilling and Remarks:

Kans 8070

Ar #2389

RECORD

Cased ____ in., ____ ft.

Sand

Gas

Oil

Total Depth 3428

PRODUCTION

1st 24 hrs. Nat.

1st 24 hrs. after shot

Gas ____ Cu. Ft.

Dry Hole

Abandoned

Date

OCT 22 1947 19

S. J. LEWIS Scout