


KANSAS

Section 23 Township 16 Range 11WWell No. #1 BisqueCompany Derby Drlg.

Kraft-Prusa Pool

NORTH

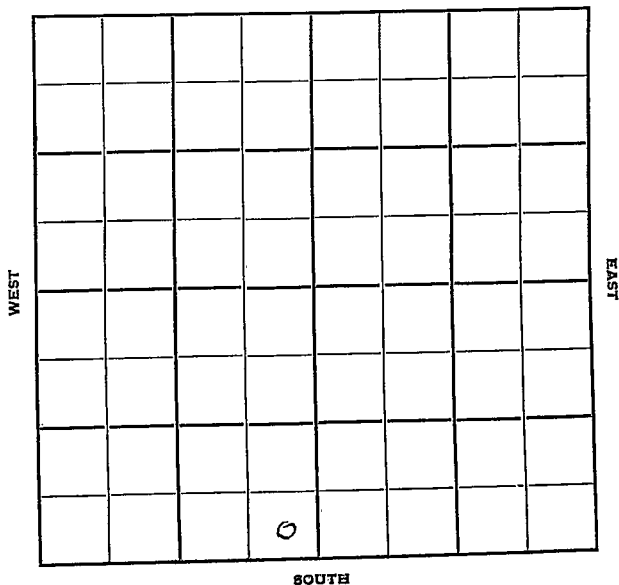

Barton **KANSAS** ✓

Sec. 23 Twp. 16 R. 11W

Well No. #1 Bisque Farm

Derby Drlg. Company
Kraft-Prusa Pool (Derby Drlg., Contr.)

 Ft. from N. Line

330'


 Ft. from S. Line

330'

 Ft. from E. Line

 Ft. from W. Line

SE SW

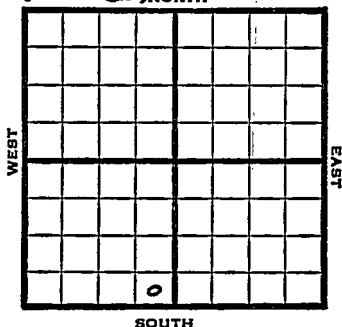

1949 Elev 1912' REPORT

11/30 Anhy 725'
8" @ 183'
Drlg. 2824'
12/7 TD 3440'
Lansing 3066'
Arb. 3388'
Aband.

ABANDONED

Map No. _____ Sec. 23 Twp. 16 R. 11W

Well No. 1 Bisque

Derby Drlg.

Company

Derby Drlg.

Contractor

SE SW


**FIRST REPORT
SECTION PLAT**

_____ Ft. from N. Line

330 Ft. from S. Line

330 Ft. from E. Line

_____ Ft. from W. Line

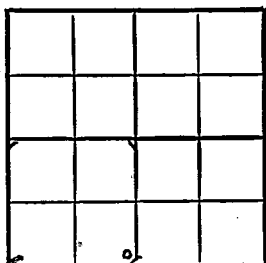

Barton County

Location _____

Rig up _____

Drilling and Remarks:

Anhy 725

8" @ 183

drlg. 2824

RECORD

Cased _____ in., _____ ft.

Sand _____

Gas _____

Oil _____

Total Depth _____

PRODUCTION

1st 24 hrs. Nat. _____

1st 24 hrs. after shot _____

Gas _____ Cu. Ft.

Dry Hole _____

Abandoned _____

Date

NOV 30 1949

19

S. J. LEWIS

Scout

Kansas

Kraft-Prusa Pool

Map No. _____ Sec. 23 Twp. 16 R. 11WWell No. 1 Bisque

Derby Drlg. _____ Company _____

ABANDONED

Contractor _____

SE SW


E. 1/9/12
SECTION PLAT

_____ Ft. from N. Line

330 Ft. from S. Line330 Ft. from E. Line

_____ Ft. from W. Line

Barton County

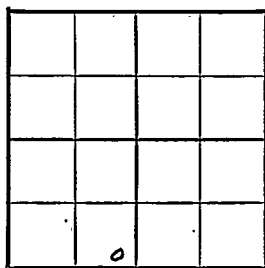

Location _____

Rig up _____

Drilling and Remarks:

Home 3066Cor 43388

RECORD

Cased _____ in., _____ ft.

Sand _____

Gas _____

Oil _____

Total Depth 3448

PRODUCTION

1st 24 hrs. Nat. _____

1st 24 hrs. after shot _____

Gas _____ Cu. Ft.

Dry Hole _____

Abandoned _____

Date

DEC 7 1949 19S. J. LEWIS Scout