
FORM 51 25M 8-50 WESTERN KANSAS Barton

Section 23 Township 16 Range 11-W

Well No. #1 Breford

Company B & R Drlg.

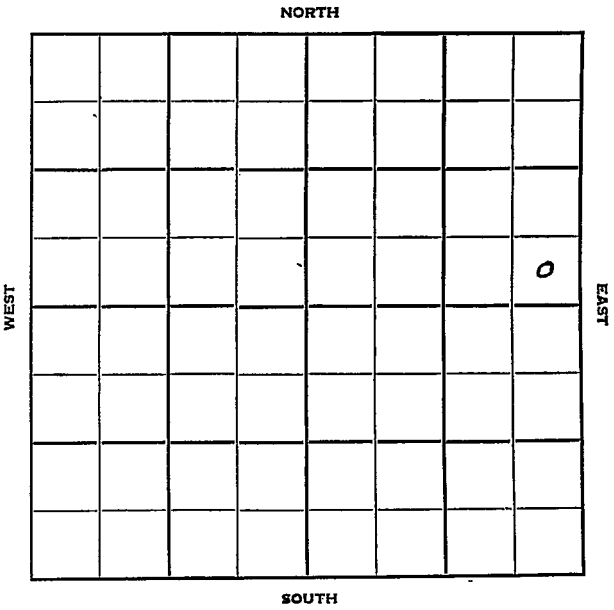

FORM 252-B
10M 10-50 PETROL

KANSAS Barton

Sec. 23 Twp. 16 R. 11-W

Well No. #1 Breford Farm

B & R Drlg. Company

B & R Drlg. Contractor

Wildcat


_____ Ft. from N. Line

330 Ft. from S. Line

330 Ft. from E. Line

_____ Ft. from W. Line

SE SE NE

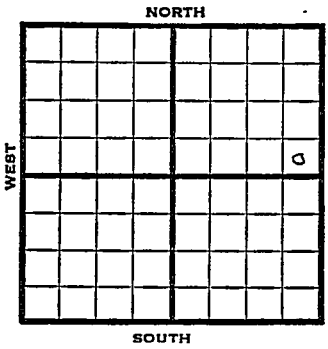

1950	Elev. 1917' REPORT
11/8	Spud 11-7-50 8 5/8" @ 182 WOC
1951 1/3	Spud 11-7-50 D&A TD 3400 8-5/8" @ 182' Heeb. 2961' Br Lime 3062 Lans. 3081 Arb. 3372-75 5" @ 3372 TD 3382 S/12 gw 8 boph 500 A no inc. DD 3400 1000 A SP 3282 1/3160-61 SSO 6/3130-36 5/3110-15 4/3080-84 7/2978-85 D&A ABANDONED

FORM 275 FOR SALE BY KANSAS BLUE PRINT CO.


County Barton State Kansas

Sec. 23 (Blk. Twp.) 16 (Sur. Rge.) 11W Map No.

Operator B & R Drlg.

Well No. 1 Farm Breford

Elev. Location SE SE NE

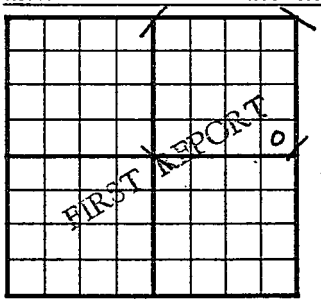

330 Ft. From S Line NE

330 Ft. From E Line Quarter

1st. Report NOV 8 1950

Completion

Remarks

B & R Drlg. - Contr.

Spudding Date 11-7-50

Drlg. Data Wildcat

8 5/8" @ 182 WOC

J. E. TYRA

FORM 275 FOR SALE BY KANSAS BLUE PRINT CO.


County Barton State Kansas

Sec. 23 (Blk. Twp.) 16 (Sur. Rge.) 11W Map No.

Operator B & R Drlg.

Well No. 1 Farm Breford

Elev. 1917 Location SE SE NE

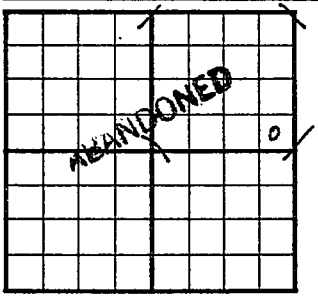

330 Ft. From S Line NE

330 Ft. From E Line Quarter

1st. Report

Completion JAN 3 1951

Remarks Wildcat

B & R Drlg. - Contr.

Spudding Date 11-7-50

Drlg. Data D & A TD 3400

8 5/8" @ 182 Heeb. 2961 Br. lime 3062

Lans. 3081 Arb. 3372-75 5" @ 3372

TD 3382 S/ 12 gw 8 goph 500 A

no inc. DD 3400 1000 A SP 3282

1/ 3160-61 SSO 6/ 3130-36 5/ 3110-15

4/ 3080-84 7/ 2978-85

D & A

J. E. TYRA