


Woodson

KANSAS

SECTION 13 TOWNSHIP 26S RANGE 14E

WELL NO. #7 Ashley

COMPANY L.M. McCormick

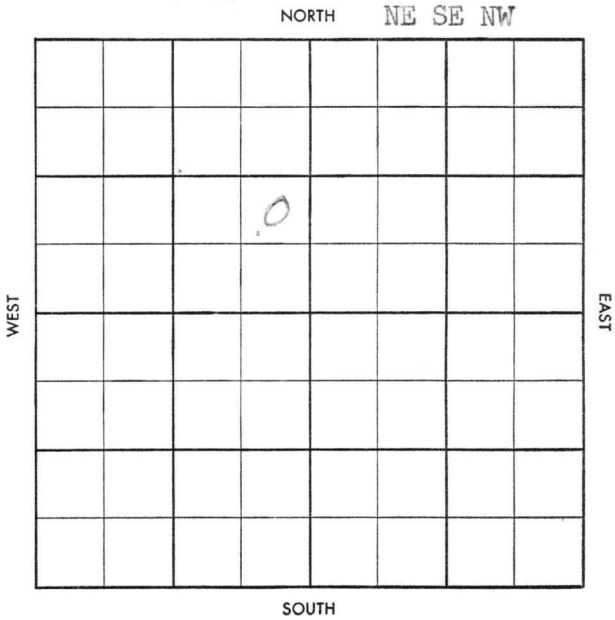



Yates Center
(534)



S-513-A

CO. Woodson ELEV. _____
 SEC. 13 TWP. 26 RGE. 14E
 COMPANY L.M. McCormick NO. 7

FEB 19 '58
 COMPLETE

FARM Ashley
 LOC. NE SE NW

GEOL. _____
 CONTRLand Drlg. rotary
 POOLBig Sandy tools
 SPUD 12-10-57
 Drlg. 1250 ETD 1300.
 DEC 26 '57 8" 100
Bart 50 1270
TD 1306
4 1/2 1306 woc
 JAN 2 '58 — JAN 6 '58

CO
 LSE
 NO.
 SEC.
 TWP.
 RGE.

perf 27/1270-90 JAN 22 '58 ✓
 frac with 400 lbs sw \$ on Ld
 JAN 29 '58 ✓ \$ 2-3 hrs a day rec
 about 70-80 BU so far FEB 5 '58
 FEB 12 '58 Rng T&R FEB 19 '58 POP
 P 7 BOPD + 7 BOPD
 Bart 1270-90