

Map No.

Sec.

Twp.

R.

Well No.

Farm

Company

NORTH

WEST

EAST

SOUTH

Location

Drilling Remarks:

Rig Up

Drilling Remarks:

RECORD

Cased _____ in. _____ ft.

Sand

Gas

Oil.

Total Depth

PRODUCTION

1st 24 hrs. Nat.

1st 24 hrs. after shot

Gas _____ cu. ft.

Dry Hole

Abandoned

Form 252A 5N 22E 5129
Sedgwick

Map No. *5* Sec. *29* Twp. *29* R. *2*


Well No. *J. Hunsaker* Farm
Hartman & Skore Company

200 Ft. from N. Line

_____ Ft. from S. Line

_____ Ft. from E. Line

200 Ft. from W. Line

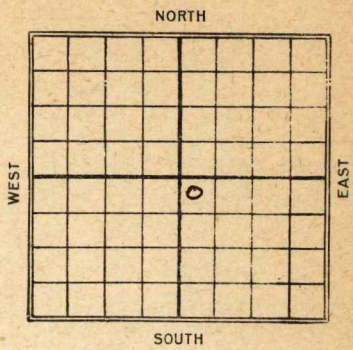

Date	REPORT
<i>1924</i>	
<i>4/23</i>	<i>Timbers.</i>
<i>7/16</i>	<i>S.D. 16' 40'</i>
<i>10/28</i>	<i>fish @ 2310'</i>
<i>11/26</i>	<i>S.D. 2430'</i>
<i>12/17</i>	<i>U.R. 6" to 2805'</i>
<i>1925</i>	
<i>6/2</i>	<i>Well Complete</i>
<i>1926</i>	
<i>9/17</i>	<i>I.R. 35-64</i>
	<i>D. & A.</i>

Sidgwick
 Map No. *29* Sec. *29* Twp. *29* R. *2*
KANSAS

Well No. *#1 Humsaker*
Hartman & Skare Company

Contractor

FIRST REPORT

SECTION PLAT

200 Ft. from N. Line

----- Ft. from S. Line

----- Ft. from E. Line

200 Ft. from W. Line

		0	

Location -----

Rig up -----

Drilling and Remarks:

Timber

RECORD

Cased ----- in., ----- ft.

Sand -----

Gas -----

Oil -----

Total Depth -----

PRODUCTION

1st 24 hrs. Nat. -----

1st 24 hrs. after shot -----

Gas ----- Cu. Ft.

Dry Hole -----

Abandoned -----

Date

APR 23 1924

M. A. BENEAR

192

Scout

Map No. **12** **KANSAS** Sec. **29** Twp. **29** R. **2E**

Well No. **11755**

Hartman & Skarr Company

Contractor

SECTION PLAT

		0	

200 Ft. from N. Line

_____ Ft. from S. Line

_____ Ft. from E. Line

200 Ft. from W. Line

ABANDONED

Location _____

Rig up _____

Drilling and Remarks:

T.D. 3564

RECORD

Cased _____ in., _____ ft.

Sand _____

Gas _____

Oil _____

Total Depth _____

PRODUCTION

1st 24 hrs. Nat. _____

1st 24 hrs. after shot _____

Gas _____ Cu. Ft.

Dry Hole _____

Abandoned _____

Date

SEP 17 1926

S. J. LEWIS

192

Scout

MAP No. K12 SEC. 29 TWP. 29S R. 28WELL No. 1Huntaker
Hortman Spack & Johnson COMPANY

CONTRACTOR

o.k. among

SECTION PLAT

		0	

_____ FT. FROM N. LINE

_____ FT. FROM S. LINE

_____ FT. FROM E. LINE

_____ FT. FROM W. LINE

LOCATION _____

RIG UP _____

DRILLING AND REMARKS:

3542 } 40 gts
3544 } HOOSIER

3563 } Water
3564 } water

RECORD

CASED _____ IN. _____ FT.

SAND _____

GAS _____

OIL _____

TOTAL DEPTH 3564

PRODUCTION

1ST 24 HRS. NAT. _____

1ST 24 HRS. AFTER SHOT _____

GAS _____ CU. FT.

DRY HOLE ☒ABANDONED ☒

DATE

3/31 192 5 SCOUT