


Section 29 Township 29 Range 2E

Well No. 1 He idrich

Company J. P. Gaty

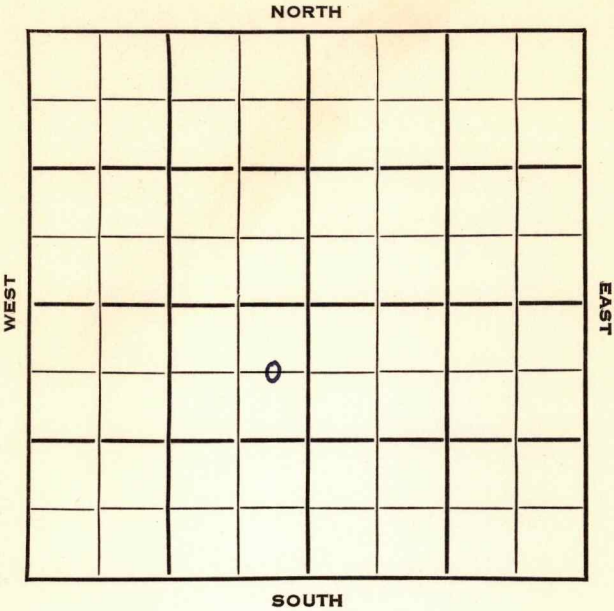

Sedgwick

KANSAS

SEC.	TWP.	R.
29	29	2 E ✓

WELL NO.

1 Heidrich

FARM

COMPANY

J. P. Gaty

CONTRACTOR

Morrison Drlg.

Wildcat


660 Ft. from N. Line

Ft. from S. Line

330 Ft. from E. Line

Ft. from W. Line

C E L NE SW

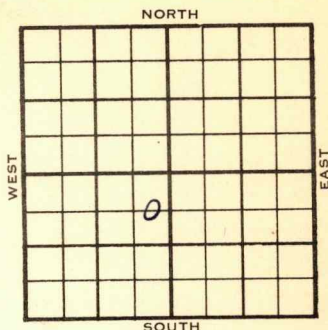

ELEVATION

1289'

REPORT

1954


3/10

8" @ 81
Drlg.

3/31

D & A	TD 3564	8" @ 81
KC 2608	Miss. 3115	Simp. 3534
TD 3540	5" @ 3540	Arb. 3561
TD 3564	HFW	
D & A		

ABANDONED

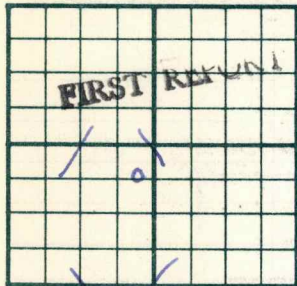County **Sedgwick** State **Kansas**Sec. **29** (Blk.) **29** (Sur.) **2E** Map No.Operator **J. P. Gaty**Well No. **1** Farm **Heidrich**Elev. Location **C E L NE SW****660** Ft. From **N** Line **SW****330** Ft. From **E** Line **Quarter**1st. Report **MAR 10 1954**

Completion

Remarks

Morrison Drlg. - Contr.

Spudding Date

Drlg. Data **Wildcat****8" @ 81 drlg.**

J. G. McGEHEE

County Sedgwick State KansasSec. 29 (Blk.
Twp.) 29 (Sur.
Rge.) 2E Map No.Operator J. P. GatyWell No. 1 Farm HeidrichElev. 1289 Location C E L NE SW660 Ft. From N Line SW330 Ft. From E Line Quarter

1st. Report

Completion MAR 31 1954Remarks WildcatMorrison Drlg. - Contr.

Spudding Date

Drlg. Data D & A TD 35648" @ 81 KC 2608 Miss. 3115Simp. 3534 TD 3540 5" @ 3540 Arb. 3561TD 3564 HFWD & A

J. G. McGEHEE