
Woodson

KANSAS

SECTION 13 TOWNSHIP 26S RANGE 14E

WELL NO. #5 Brewer

COMPANY Big Sandy Oil Corp.

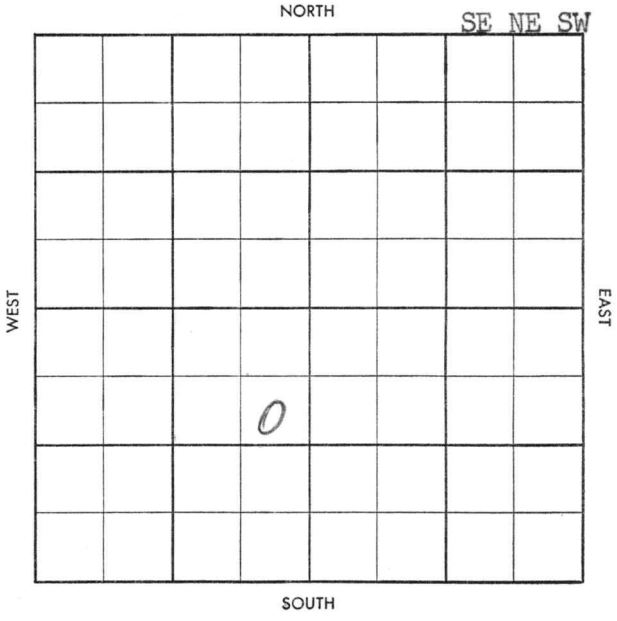

FORM 504-3 SUNRAY

BT

S-513-B

County Woodson Elev.

Sec. 13 Twp. 26 Rge. 14E

Company Big Sandy Oil Corp.

Farm Name Brewer No. 5

TOPS	DEPTH	LOG	DATUM
Anh.			
Tp.			
H.			
Tr.			
Dg.			
B. L.			
L.			
K.C.			
B.K.C.			
Ce.			
C.			
M.			
M.			
K.			
Mz.			
Mq.			
V.			
S.			
S.			
A.			
R.			
Pf.			
G.			
T.D.	1284		

Loc. in Sec. SE NE SW

Geol.

Contr. Sandlin

Pool Big Sandy

JAN 22 '58

FIRST REPORT

1-9-58

Date Comm.

4" cemented @ 1260/138

Co. Lse. No. Sec. T. R.

Twp. Pool

Co. Facet

S-513-B

County Woodson Elev.

Sec. 13 Twp. 26 Rge. 14E

Company Big Sandy Oil Corp.

Farm Name Brewer No. 5

TOPS	DEPTH	LOG	DATUM
Anh.			
Tp.			
H.			
Tr.			
Dg.			
B. L.			
L. Squirrel	1035		
K.C.			
B.K.C.			
Ce.			
C. Bart	1234		
M.			
M.			
K.			
Mz.			
Mq.			
V.			
S.			
S.			
A.			
R.			
Pf.			
G.			
T.D. 1260	~~1281~~		

Loc. in Sec. SE NE SW

Geol.

Contr. Candlin

Pool Big Sandy

COMPLETE

JUL 9 '58

Date Comm. 1-9-58

4½" cemented @ ~~1260~~ 1256/138 JAN 29 '58 FEB 5 '58

Crd 1035-44½

full rec. crd 1234-1260 full rec

X FEB 19 '58 X WO

FEB 26 MAR 5 '58 MAR 12 '58 MAR 19 '58 MAR 26

APR 2 '58 APR 9 '58 APR 16 '58 APR 23 '58 APR 30 '58 MAY 7 '58

MAY 14 '58 MAY 21 '58 MAY 28 '58 JUN 3 '58 JUN 11 '58 JUN 18 '58

JUN 25 '58 ~~4½ 1256 CO 1260 Rec~~

~~Rec~~ JUL 2 '58 JUL 9 '58 Correct 4½

1260 CO DD 1264 TD

FORM 513-1 SUNRAY

13/1040-44. frac pop
P 23-24 BOPd + 60 BW pd
gr 26.5°
P 15 BOPd + 45 BWPd
gr 26.5°
Squirrell 1040-44
Bart openhole 1260-64

13-26-14E SENESW