

Map No. None Sec. 12 Twp. 29 R. 3

Well No. 1 a L Hardy Farm
Empire Company

NORTH

WEST

EAST

SOUTH

Location -----

Rig up -----

Drilling and remarks:

RECORD

Cased ----- in. ----- Ft.

Sand -----

Gas -----

Oil -----

Total Depth -----

PRODUCTION

1st 24 hrs. Nat. -----

1st 24 hrs. after shot -----

Gas ----- Cu. Ft.

Dry Hole -----

Abandoned -----

FIRST REPORT

Date


11-7, 1917, Carley Scout

Map No. *K12* Sec. *12* Twp. *29* R. *3*

Well No. *2784* Farm _____
Engine Company _____

NORTH

WEST

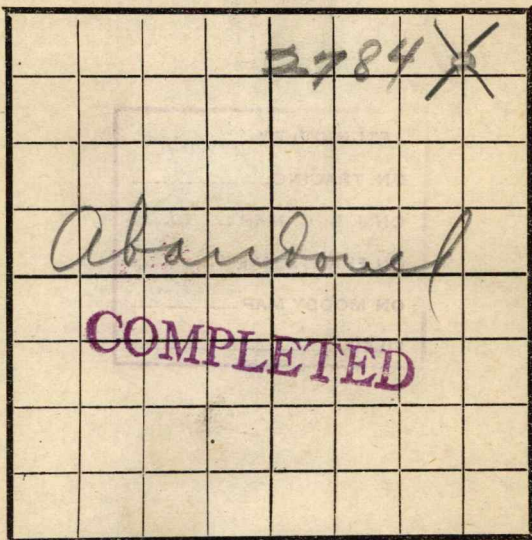

EAST

SOUTH

Location _____
Rig Up _____
Drilling and remarks _____

RECORD

Cased _____ in. _____ Ft.
Sand _____
Gas _____
Oil _____
Total Depth _____

PRODUCTION

1st 24 hrs. Nat. _____
1st 24 hrs. after shot _____
Gas _____ Cu. Ft.
Dry Hole _____
Abandoned _____

Kansas | *2784*


Date

3/22 191*8* *S. Conroy* Scout

Map No. *K12* Sec. *12* Twp. *29* R. *3*

Well No. *1700* Farm _____
Engine Company _____

NORTH

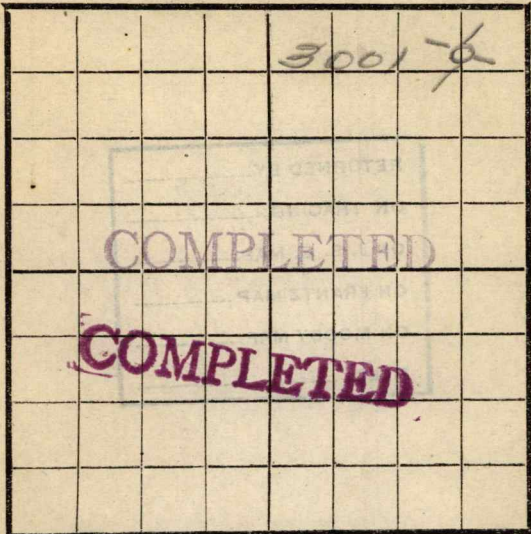

WEST

EAST

SOUTH

RECORD

Location _____

Cased _____ in. _____ Ft

Rig Up _____

Sand _____

Drilling and remarks

Gas _____

Dry and

Oil _____

abandoned

Total Depth _____

3001'

PRODUCTION

1st 24 hrs. Nat. _____

1st 24 hrs. after shot _____

Gas _____ Cu. Ft.

Dry Hole _____

Abandoned _____

Date

4/30, 191*8*

Cudry

Scout

Butler

MAP NO. *K12* **KANSAS** SEC. *12* TWP. *29S* R. *3E*

WELL NO. *1 Hardy*

Empire COMPANY

CONTRACTOR

SECTION PLAT

ABANDONED

		0

_____ FT. FROM N. LINE

_____ FT. FROM S. LINE

_____ FT. FROM E. LINE

_____ FT. FROM W. LINE

LOCATION _____

RIG UP _____

DRILLING AND REMARKS:

*clear agree
Lee*

RECORD

CASED _____ IN., _____ FT.

SAND _____

GAS _____

OIL _____

TOTAL DEPTH *3001*

PRODUCTION

1ST 24 HRS. NAT. _____

1ST 24 HRS. AFTER SHOT _____

GAS _____ CU. FT.

DRY HOLE *✓*

ABANDONED *✓*

DATE

5/6 18

SCOUT