


Woodson

Map No. *15* Sec. *13* Twp. *26* R. *14*
 Well No. *3 - Daniels* Farm
Skelly Oil Company

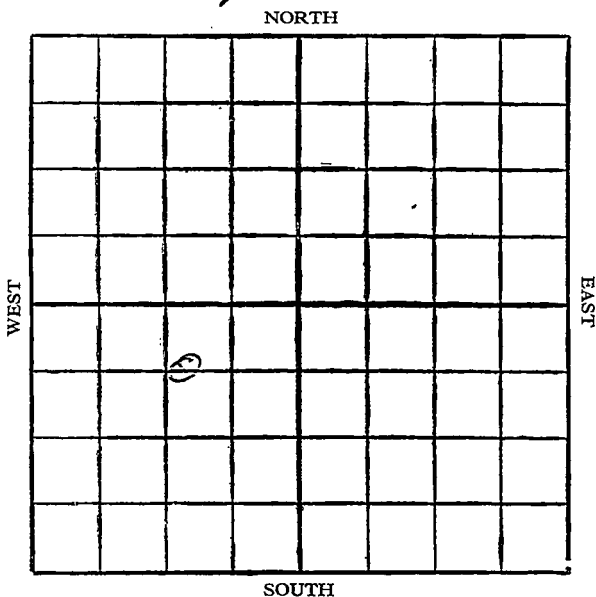

Location

Drilling Remarks

Rig Up

Drilling Remarks

RECORD

Cased in. ft.

Sand

Gas

Oil

Total Depth

PRODUCTION

1st 24 hrs. Nat.

1st 24 hrs. after shot

Gas cu. ft.

Dry Hole

Abandoned


woodson

Map No. 15 Sec. 13 Twp. 26 R. 14Well No. 2 - Daniels FarmSkelly oil Company660 Ft. from N. Line

_____ Ft. from S. Line

1070 Ft. from E. Line

_____ Ft. from W. Line

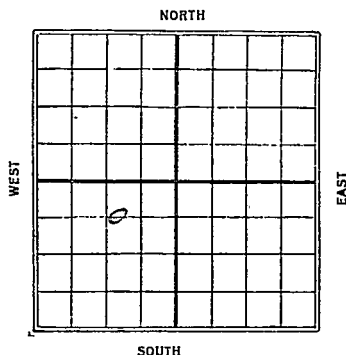1926

Date

REPORT

12/22 Location12/30 _____19271/6 _____1/13 _____1/19 _____1/26 _____2/3 _____2/10 _____2/17 sandy shale 1253-1312show oil - Drlg 13202/24 sdly shale 1253-1312show oilN & A 1398 - 7 P.

Woodson

~~KANSAS~~ Map No. _____ Sec. 13 Twp. 26 R. 14

Well No. 2 Daniels

Stelly oil Co. Company

Contractor

FIRST REPORTS

SECTION PLAT

660 Ft. from N. Line

Ft. from S. Line

1070 Ft. from E. Line

Ft. from W. Line

	X	X	
	X	X	

Location ✓

Rig up

Drilling and Remarks:

RECORD

Cased _____ in., _____ ft.

Sand _____

Gas _____

Oil _____

Total Depth _____

PRODUCTION

1st 24 hrs. Nat. _____

1st 24 hrs. after shot _____

Gas _____ Cu. Ft.

Dry Hole _____

Abandoned _____

Date

DEC 22 1926

CHAS. L. SHERWOOD

192

Scout

Woodson
KANSAS
Map No. _____ Sec. *13* Twp. *26* R. *14*
Well No. *2 Daniela*
Holly oil Co Company
Contractor

COMPLETED

SECTION PLAT

_____ Ft. from N. Line
660 Ft. from S. Line
1070 Ft. from E. Line
_____ Ft. from W. Line
ABANDONED

	<i>o</i>		

Location _____
Rig up _____
Drilling and Remarks:
dry shale
1253-1312' sho
ad
1254 1398'

RECORD

Cased _____ in., _____ ft.
Sand _____
Gas _____
Oil _____
Total Depth *1398*

PRODUCTION

1st 24 hrs. Nat. _____
1st 24 hrs. after shot _____
Gas _____ Cu. Ft.
Dry Hole ☒
Abandoned ☒

Date
FEB 24 1927

CHAS. L. SHERWOOD