

Butler

FORM 51 IOM 12-46 PETROL


**KANSAS**

Section 11 Township 29 Range 3-E

Well No. #1 Randall

Company J. P. Gatty

**Wildcat** NORTH

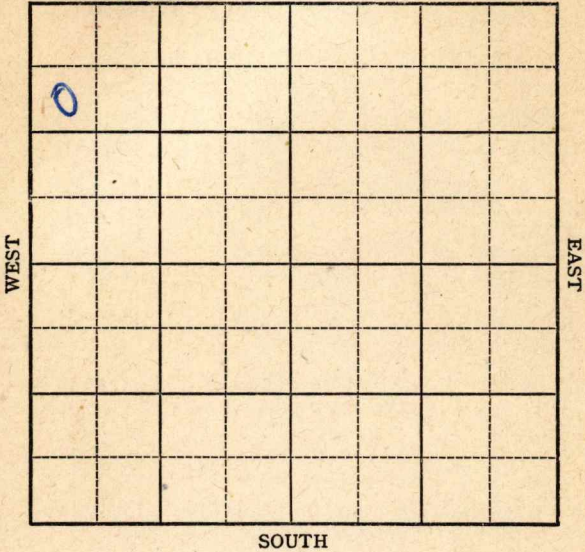

Sec. 11 Twp. 29 R. 3-E

Well No. 1 Randall Farm

J. P. Gatty Company

Wildcat


990 Ft. from N. Line

\_\_\_\_\_ Ft. from S. Line

\_\_\_\_\_ Ft. from E. Line

330 Ft. from W. Line

SW NW NW

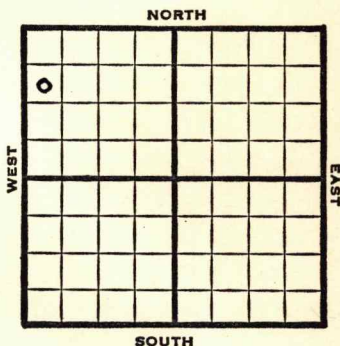

1947 **Elev. 1243** REPORT

- 8/20 Loc.
- 8/27 Mach.
- 9/3 15" @ 130'  
Drlg. 495'
- 9/10 Drlg. 1420'  
13" @ 915'
- 9/17 **Lansing 1980'**  
Drlg. 1989'
- 9/24 8" @ 1985'  
Drlg. 2575'
- 10/1 **Simpson 2988**  
**TD 3005**

**ABANDONED**

Map No. \_\_\_\_\_ Sec. 11 Twp. 29 R. 3E

Well No. 1 Randall

J. P. Gatty Company

**FIRST REPORT**

Contractor

SW NW NW

**SECTION PLAT**

990 Ft. from N. Line

\_\_\_\_\_ Ft. from S. Line

\_\_\_\_\_ Ft. from E. Line

330 Ft. from W. Line

0			

Butler County

Location X

Rig up \_\_\_\_\_

Drilling and Remarks:

**RECORD**

Cased \_\_\_\_\_ in., \_\_\_\_\_ ft.

Sand \_\_\_\_\_

Gas \_\_\_\_\_

Oil \_\_\_\_\_

Total Depth \_\_\_\_\_

**PRODUCTION**

1st 24 hrs. Nat. \_\_\_\_\_

1st 24 hrs. after shot \_\_\_\_\_

Gas \_\_\_\_\_ Cu. Ft.

Dry Hole \_\_\_\_\_

Abandoned \_\_\_\_\_

Date

AUG 20 1947

19

S. J. LEWIS

Scout

Map No. 17 Sec. 11 Twp. 29 R. 3E

Well No. 1 Randall

J. P. Gatty Company

**BANDONED**

Contractor

SW NW NW

*E1,1243*  
**SECTION PLAT**

6			

990 Ft. from N. Line

         Ft. from S. Line

         Ft. from E. Line

330 Ft. from W. Line

Butler County

Location                                 

Rig up                                 

Drilling and Remarks:

*Shut 2988*

**RECORD**

Cased          in.,          ft.

Sand                                 

Gas                                 

Oil                                 

Total Depth 3000

**PRODUCTION**

1st 24 hrs. Nat.                         

1st 24 hrs. after shot                         

Gas                                  Cu. Ft.

Dry Hole                                 

Abandoned                                 

Date

OCT 1 1947 19

S. I. LEWIS Scout