


Section 24 Township 16 Range 11-W

Well No. #1 Homolka

Company Shell

NORTH Prusa Pool

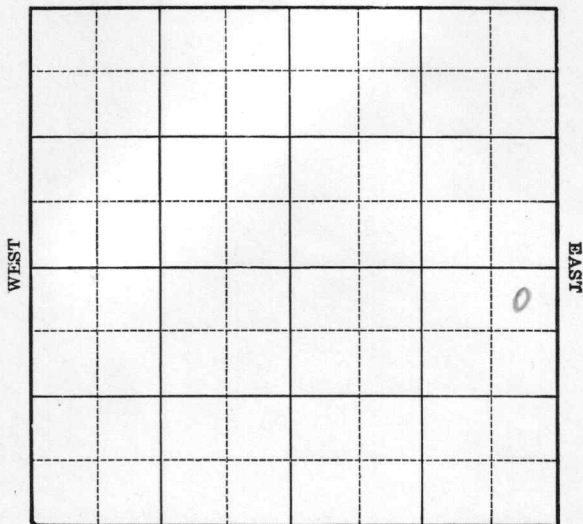

SOUTH

KANSAS


Barton

Sec. 24 Twp. 16 R. 11-WWell No. #1 Homolka FarmShell Company

(Prusa)

330 Ft. from N. Line Ft. from S. Line330 Ft. from E. Line Ft. from W. Line

Elev. 1901

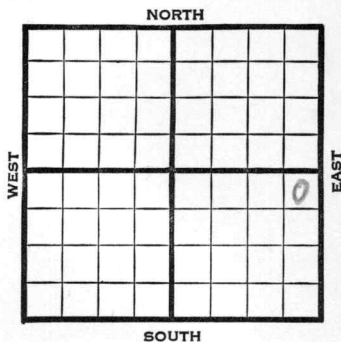

1940

REPORT

11/6 Drlg. 95'

11/14 8" - 549' Anhy 708'

Ft. Riley 1670' Wreford 1825'

Drlg. 2205'

11/21 Topeka 2693' Lans. 3071'

Drlg. 3211'

11/26 Arb. 3441'

T.D. 3468'

No shows.

ABANDONED

Map No. 55 Sec. 24 Twp. 16 R. 11WWell No. 1 HomolkaShell

Company

Contractor

FIRST REPORT

NE SE

330 Ft. from N. Line Ft. from S. Line330 Ft. from E. Line Ft. from W. Line

SECTION PLAT

			6

PRUSA POOL

Location Rig up

Drilling and Remarks:

Drlg. 95

RECORD

Cased in., ft.Sand Gas Oil Total Depth

PRODUCTION

1st 24 hrs. Nat. 1st 24 hrs. after shot Gas Cu. Ft.Dry Hole Abandoned

Date

NOV 6 1940 19

S. J. LEWIS

Scout

Map No. 35 Sec. 24 Twp. 16 R. 11WWell No. 1 HomolkaShell

Company

Contractor

ABANDONED

NE SE

330 Ft. from N. Line Ft. from S. Line330 Ft. from E. Line Ft. from W. Line

PRUSA POOL

SECTION PLAT

			o

Location Rig up

Drilling and Remarks:


RECORD

Cased in., ft.Sand Gas Oil Total Depth 3468

PRODUCTION

1st 24 hrs. Nat. 1st 24 hrs. after shot Gas Cu. Ft.Dry Hole Abandoned

Date

NOV 26 1940 19S. J. LEWIS Scout