

LOG OF WELL

Owner MID KANSAS OIL & GAS COMPANY  
 Contractor M.K.L. & G Co.  
 Drilling Dec. 18, 1917  
 " completed May 31- 1918  
 Total Depth 2875 feet  
 Production: Initial Dry Bbls.

Farm W.S. Bacon Well No. 1  
 District or Pool  
 Sec. 12, Twp. 29S, Range 3 East.  
 Butler County, State of Kans.

*From Daily Oil Co*  
 12-29-3 11:12  
 12-293 E

CASING RECORD.

20" ft. 8 1/4 1810 ft.  
 15 1/2 210 ft. 65/8 2405 ft.  
 12 1/2" 495 ft. 5 3-16" 2592 Ft.  
 10" 1210 ft.

Plotted

SE CORNER

Formation	Top	Bottom	Thickness	Color	Hard Or S.	Remarks
soil		40	40			
gravel		50	10			
lime		55	5	White		
slate		60	5	black		
hard pan		70	10		Hard	
rock red		80	10			
slate		90	10	light		
slate		100	10	dark		
lime		105	5	white		8 B.W.
slate		190	85			
water sand		200	10			10 B.W.
lime		230	30			
slate		250	20			
lime		260	10			
shale		340	80			
slate		360	20			
lime		375	15			
shale		415	40	light		
lime		475	60			
red rock		485	10			H.F.W.450
Gravelly slate		495	10			
slate		500	5	dark		
lime		505	5	white		
slate		515	10	dark		
shale		535	20	light		
slate		570	35	dark		
lime		635	65			
slate		645	10	dark		
slate		685	40	light		1 B.W.
slate		730	45			
lime		745	15			
slate		820	75			
lime		840	20			
shale		850	10			
slate		965	115			
lime		990	25			
slate		1010	20			
lime		1020	10			
slate		1035	15			
lime		1050	15			
slate		1070	20			
lime		1100	30			
slate		1150	50			12 B.W.1265'
lime		1180	30			
slate		1190	10			
lime		1210	20			
slate		1240	30			
lime		1280	40			
slate		1360	60			
lime		1450	90			
slate		1465	15			
lime		1495	30			
slate		1520	25			
lime		1535	15			
slate		1565	30			
lime		1600	35			
slate		1630	30			


12-27-22

Formation	Top	Bottom	Thickness	Color	Hard or s.	Remarks.
lime		1730	100			3 B.W.1710'
slate		1800	70			
lime		1820	20			
slate		1875	55			
sandy lime		1895	20			
slate		1935	40			
lime		1960	25			
sand		1961	1			show oil & gas
lime		1990	29			
slate		2025	35			
lime		2065	40			
slate		2070	5			
lime		2115	45			
slate		2260	145			
lime		2300	40			1 B.W.
sand		2325	25			
lime		2350	25			
dry water sand		2369	19			
lime		2435	66			
shale		2440	5	black		
sandy lime		2480	40			
lime		2488	8			
shale		2500	12			
slate		2503	3			
lime		2508	5			
shale		2530	22			
sand		2546	16			
lime		2584	38			
shale		2620	36			
lime		2634	14			
shale		2700	66			
slate		2735	35			
shale		2755	20			
lime		2850	95			
slate		2875	25			dry total depth

STATE OF KANSAS  
BUTLER COUNTY

Sec. 12 Twp. 22S R. 22E  
Farm Baer No. 1  
Mid Kansas Company  
Elev. T. D.  
Log No.

22871

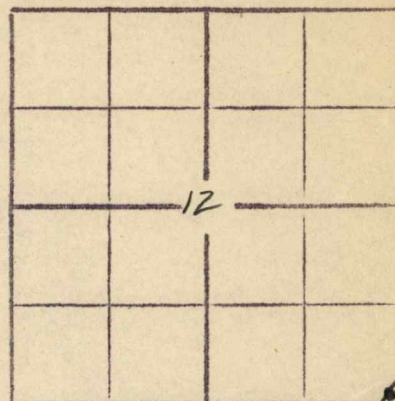

Soil	40
Gravel	50
Lime white	55
Black slate	60
Hard pan	70
R.R.	80
Slate light	90
Slate dark	100
Lime white wtr	105
Slate	190
Sand wtr	200
Lime	230
Slate	250
Lime	260
Shale	340
Slate	360
Lime	375
Shale light	415
Lime HFW 450	475
R.R.	485
Slate & gravel	495
Slate dark	500
Lime white	505
Slate dark	515
Shale light	535
Slate dark	570
Lime	635
Slate dark	645
Slate light wtr	685
Slate	730
Lime	745
Slate	820
Lime	840
Shale	850
Slate	965
Lime	990
Slate	1010
Lime	1020
Slate	1035
Lime	1050
Slate	1070
Lime	1100
Slate	1150
Lime	1180
Slate	1190
Lime	1210
Slate	1240
Lime wtr 1265	1280
Slate	1360
Lime	1450
Slate	1465
Lime	1495
Slate	1520
Lime	1535
Slate	1565
Lime	1600
Slate wtr 1710	1630
Lime	1730
Slate	1800
Lime	1820
Slate	1875
Sandy lime	1895
Slate	1935
Lime	1960
Sand O&G	1961
Lime	1990
Slate	2025
Lime	2065

Comm 12-18-17  
Comp 5-31-18

Casing	
15	210
12	495
10	1210
8	1810
6-	2405
5	2592

-	
Slate	2070
Lime	2115
Slate	2260
Lime wtr	2300
Sand	2325
Lime	2350
Sand	2369
Lime	2435
Shale black	2440
Sandy lime-	2480
Lime	2488
Shale	2500
Slate	2500
Lime	2508
Shale	2530
Sand	2546
Lime	2584
Shale	2620
Lime	2634
Shale	2700
Slate	2735
Shale	2755
Lime	2850
Slate	2875 TD Dry