

Map No. _____ Sec. 12 Twp. 29 E. 3

Well No. 1 Lichtliter Farm
Box-Mon. Oil Company

NORTH

WEST

EAST

COMPLETED

SOUTH

Location -----

Drilling Remarks:

Rig Up-----

Drilling Remarks:

RECORD

Cased----- in.-----ft.

Sand _____

Gas -----

Oil _____

Total Depth_____

PRODUCTION

1st 24 hrs. Nat.-----

1st 24 hrs. after shot-----

Gas-----cu. ft

Dry Hole_____

Abandoned -----


NORTH

Ko

WEST

COMPLETED

1811

20

EAST

SOUTH

Location _____

Rig up _____

Drilling and Remarks:

*Dry and
abandoned
1810'*

RECORD

Cased _____ in., _____ ft.

Sand _____

Gas _____

Oil _____

Total Depth _____

PRODUCTION

1st 24 hrs. Nat. _____

1st 24 hrs. after shot _____

Gas _____ Cu. Ft.

Dry Hole _____

Abandoned _____


Date

6/25 1918 Carly Scout

Map No. none Sec. 12 Twp. 29 R. 3Well No. Lichtliter Farm
Box - Mon Oil Company

NORTH

WEST

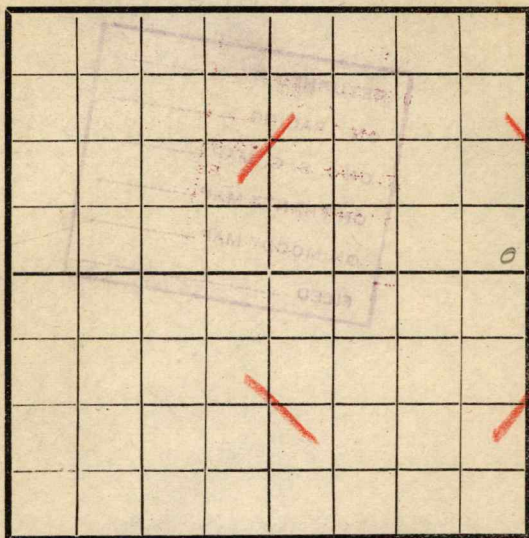

EAST

SOUTH

RECORD

Location -----

Cased ----- in. ----- Ft.

Rig Up -----

Sand -----

Drilling and remarks

Gas -----

Oil -----

Total Depth -----

PRODUCTION

1st 24 hrs. Nat. -----

1st 24 hrs. after shot -----

Gas ----- Cu. Ft.

Dry Hole -----

Abandoned -----


Date

1/9, 1918 C. Conley Scout

Map No. 112 Sec. 12 Twp. 29 R. 3Well No. 1. LicklitterBox man Company

Contractor

NORTH

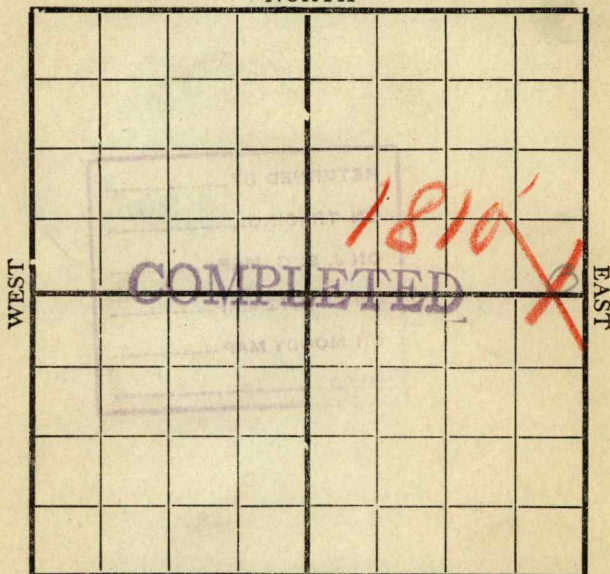

SOUTH

Location _____

Rig up _____

Drilling and Remarks:

1800Shut DownDry & abandoned6/25/8 = 1810

RECORD

Cased _____ in., _____ ft.

Sand _____

Gas _____

Oil _____

Total Depth 1810

PRODUCTION

1st 24 hrs. Nat. _____

1st 24 hrs. after shot _____

Gas _____ Cu. Ft.

Dry Hole _____

Abandoned _____

Date

6/19 8 Quariff Scout