
KANSAS
FORM 51-9M 1-42 PETROL

Barton

Section 26 Township 16 Range 11-W

Well No. #1 Kraft

Company Ohio Oil

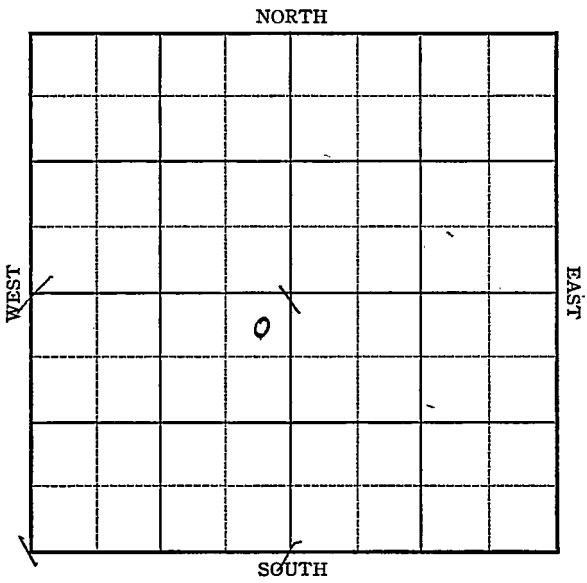

FORM 252-A
5M 9-42 GASS

KANSAS

Brton

Sec. 26 Twp. 16 R. 11-W

Well No. #1 Kraft Farm

Ohio Oil Company

Kraft Prusa


330 Ft. from N. Line

Ft. from S. Line

330 Ft. from E. Line

Ft. from W. Line

Elev. 1912

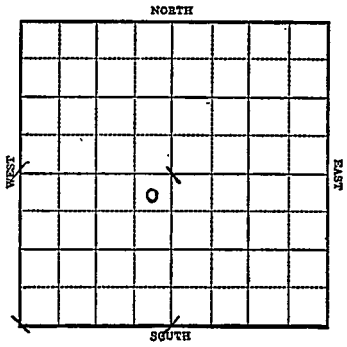

1943	REPORT
4/28	Location.
5/5	Rotary
5/12	8" @ 295' Anhy 715' Drlg. 731'
5/19	Drlg. 2435
5/26	Lans 3057 Arb. 3418 T.D. 3458'
	ABANDONED

Form 26 200 Bks 5-42 Petrol

KANSAS Barton

Map No. 55 Sec. 26 Twp. 16 R. 11W

Well No. 1 Kraft

Ohio Oil Company

FIRST REPORT Contractor

NE SW


330 Ft. from N. Line

_____ Ft. from S. Line

330 Ft. from E. Line

_____ Ft. from W. Line

SECTION PLAT

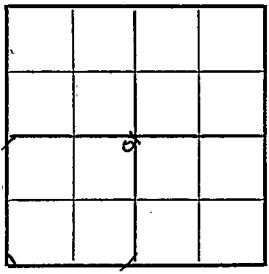

KRAFT PRUSA POOL

Location XXX

Rig up

Drilling and Remarks:

RECORD

Cased ____ in., ____ ft.

Sand

Gas

Oil

Total Depth

PRODUCTION

1st 24 hrs. Nat.

1st 24 hrs. after shot

Gas ____ Cu. Ft.

Dry Hole

Abandoned

Date

APR 28 1943 19 S. J. LEWIS Scout

Form 26 200 Bks 5-42 Petrol Barton

KANSAS

Map No. 59 Sec. 26 Twp. 16 R. 11W

Well No. 1 Kraft

Ohio Oil Company

ABANDONED Contractor

NE SW


330 Ft. from N. Line

_____ Ft. from S. Line

330 Ft. from E. Line

_____ Ft. from W. Line

SECTION PLAT

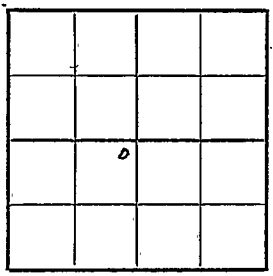

KRAFT PRUSA POOL

Location _____

Rig up _____

Drilling and Remarks:

Lane 3057

Ark 3418

RECORD

Cased _____ in., _____ ft.

Sand _____

Gas _____

Oil _____

Total Depth 3458

PRODUCTION

1st 24 hrs. Nat. _____

1st 24 hrs. after shot _____

Gas _____ Cu. Ft.

Dry Hole _____

Abandoned _____

Date

MAY 2 6 1943 19

S. J. LEWIS Scout