

Woodson County

Miscellaneous


FORM 51 IOM 12-46 PETROL

KANSAS

Section 13 Township 26 Range 14E

Well No. 1 Dole

Company Sheedy et al.

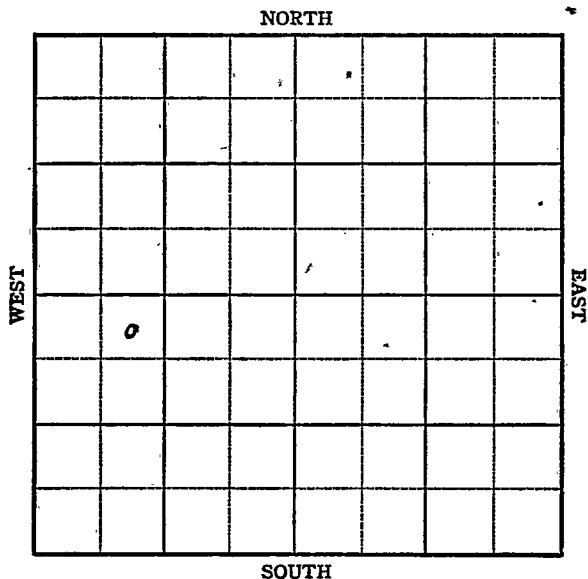

Sec. 13 Twp. 26 R. 14-E

Well No. #1 Dole Farm

Sheedy etal Company


Miscellaneous

330 Ft. from N. Line

 Ft. from S. Line

 Ft. from E. Line

990 Ft. from W. Line

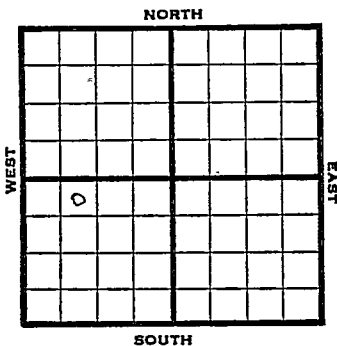

NE NW SW

REPORT

1947

3/5 Machine

3/11 12" @ 40'
10" @ 602'
Drlg 685'

3/18 TD 1278'
SD

3/25 " "

4/2 Bart 1253'
TD 1278'.

ABANDONED

Kansas

Map No. 17 Sec. 13 Twp. 26 R. 14E

Well No. 1 Dole

Sheedy et al. Company

FIRST REPORT Contractor

NE NW SW

SECTION PLAT

330 Ft. from N. Line

_____ Ft. from S. Line

_____ Ft. from E. Line

990 Ft. from W. Line

Woodson County

Location _____

Rig up _____

Drilling and Remarks:

Machine _____

RECORD

Cased _____ in., _____ ft.

Sand _____

Gas _____

Oil _____

Total Depth _____

PRODUCTION

1st 24 hrs. Nat. _____

1st 24 hrs. after shot _____

Gas _____ Cu. Ft.

Dry Hole _____

Abandoned _____

Date

MAR 5 1947 19

S. J. LEWIS Scout

Map No. K17 Sec. 13 Twp. 26 R. 14E

Well No. 1 Dole

Sheedy et al. Company

ABANDONED

Contractor

NE NW SW

330 Ft. from N. Line

_____ Ft. from S. Line

_____ Ft. from E. Line

990 Ft. from W. Line

SECTION PLAT

Woodson County

Location _____

Rig up _____

Drilling and Remarks:

Bar Y1253

RECORD

Cased _____ in., _____ ft.

Sand _____

Gas _____

Oil _____

Total Depth 1278

PRODUCTION

1st 24 hrs. Nat. _____

1st 24 hrs. after shot _____

Gas _____ Cu. Ft.

Dry Hole _____

Abandoned _____

Date

APR 2 1947 19

S. J. LEWIS Scout