


Section 26 Township 16 Range 11-W

Well No. #1 Kraft

Company Nadel & Gussman

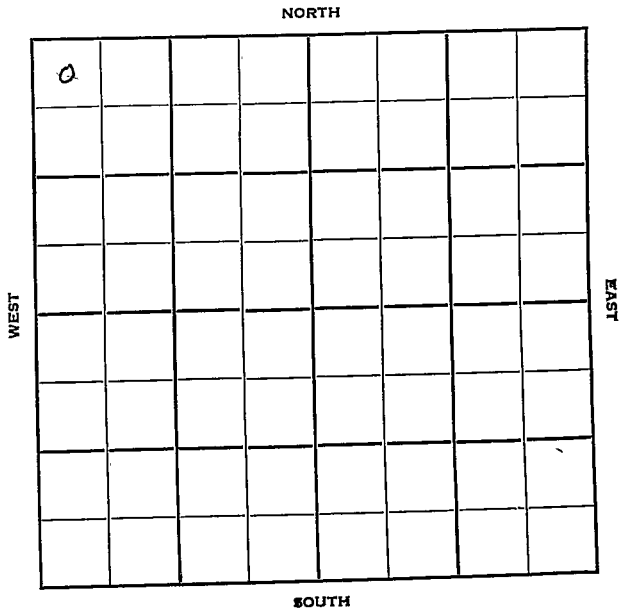

Sec. 26 Twp. 16 R. 11W

Well No. #1 Kraft Farm

Nadel & Gussman Company

Reserve Drlg.- Contr. Contractor

Kraft-Prusa Pool


330' Ft. from N. Line

_____ Ft. from S. Line

_____ Ft. from E. Line

330' Ft. from W. Line

NW NW NW

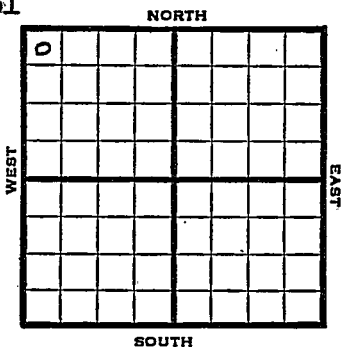

1950 Elev. 1922' REPORT

10/18

Spud 10-14-50
8-5/8" @ 270'
Anhy 755-85'
Drlg. 1467'

11/1

Spud 10-14-50
8-5/8" @ 270'
D&A TD 3425
Anhy 755-85' Heeb. 2964'
Toronto 2983' Br Lime 3060'
Lans. 2079' Cong. 3373'
Arb. 3402-25 TD
D&A

ABANDONED

County Barton State Kansas

Sec. 26 (Blk. 16) (Sur. 11W) (Twp. 16) (Rge. 11W) Map No.

Operator Nadel & Gussman

Well No. 1 Farm Kraft

Elev. _____ Location NW NW NW

10					

FIRST REPORT

330 Ft. From N Line NW

330 Ft. From W Line Quarter

1st. Report OCT 18 1950

Completion _____

Remarks _____

Reserve Drlg. - Contr.

Spudding Date 10-14-50

Drlg. Data Kraft-Prusa Pool

8 5/8" @ 270 Anhy 755-85 drlg. 1467

County Barton State Kansas

Sec. 26 (Blk. Twp.) 16 (Sur. Rge.) 11W Map No.

Operator Nadel & Gussman

Well No. 1 Farm Kraft

Elev. 1922. Location NW NW NW

0					

ABANDONED

330 Ft. From N Line NW

330 Ft. From W Line Quarter

Ist. Report

Completion NOV 1 1950

Remarks Kraft-Prusa Pool

Reserve Drlg. - Contr.

Spudding Date 10-14-50

Drlg. Data D & A TD 3425

8 5/8" @ 270 Anhy 755-85 Heeb. 2964

Toronto 2983 Br. lime 3060 Lans. 3079

Cong. 3373 Arb. 3402-25 TD

D & A

J. E. TYRA