
FORM 51 25M 8-50 WESTERN Barton KANSAS

Section 26 Township 16 Range 11 W

Well No. # 2 Kraft

Company ElDorado Ref.

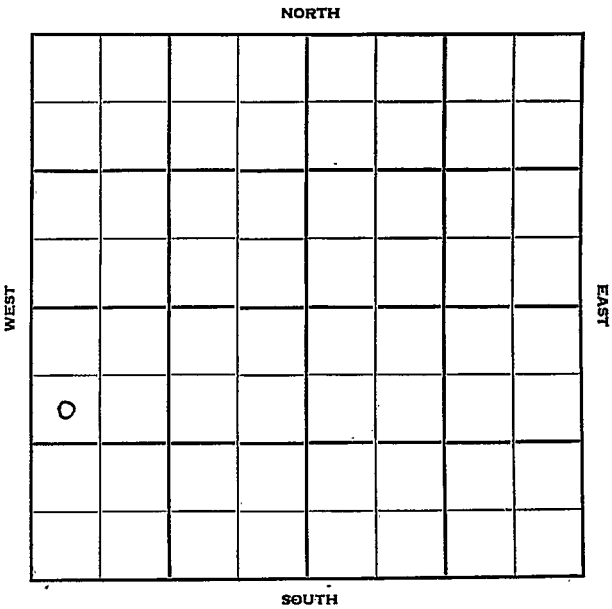

FORM 252-B
10M 11-50 PETROL

Barton KANSAS

Sec. 26 Twp. 16 R. 11W

Well No. #2 Kraft - Farm

El Dorado Ref. Company

Sterling - Contr. Contractor

Kraft Prusa Pool


990' Ft. from N. Line

Ft. from S. Line

Ft. from E. Line

330' Ft. from W. Line

SW NW SW

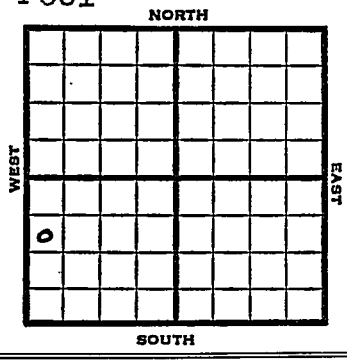

1951	Elev. 1925' REPORT
9/19	RUR
10/31	Spud 9-18-51 Oil well TD 3379' 8" @ 318' Anhy 750' Heeb 2964' Tor. 2984' Br. lime 3066' Lans. 3080' Arb. 3359-64' 5" @ 3361' TD 3379 S/5 BOPH Comp. 173 BOPD COMPLETED

FORM 275 FOR SALE BY KANSAS BLUE PRINT CO.


County Barton State Kansas

Sec. 26 (Blk. Twp.) 16 (Sur. Rge.) 11W Map No.

Operator ElDorado Ref.

Well No. 2 Farm Kraft

Elev. Location SW NW SW

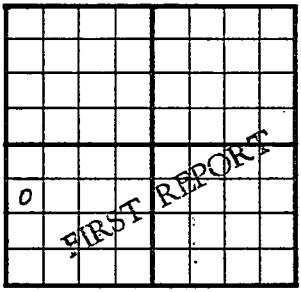

990 Ft. From N Line SW

330 Ft. From W Line Quarter

1st. Report SEP 19 1951

Completion

Remarks

Sterling - Contr.

Spudding Date

Drlg. Data Kraft Prusa - pool

RUR

J. E. TYRA

FORM 275 FOR SALE BY KANSAS BLUE PRINT CO.


County Barton State Kansas

Sec. 26 (Blk. Twp.) 16 (Sur. Rge.) 11W Map No.

Operator ElDorado Ref.

Well No. 2 Farm Kraft

Elev. 1925 Location SW NW SW

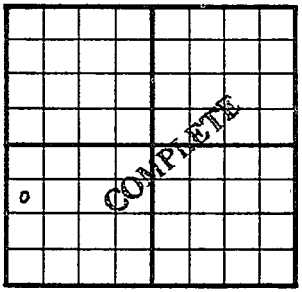

990 Ft. From N Line SW

330 Ft. From W Line Quarter

1st. Report

Completion OCT 31 1951

Remarks Kraft-Prusa Pool
Sterling Drlg. - Contr.

Spudding Date 9-18-51

Drlg. Data - Oil well TD 3379

8" @ 318 Anhy 750 Heeb. 2964

Tor. 2984 Br. lime 3066 Lans. 3080

Arb. 3359-64 5" @ 3361 TD 3379

S/ 5 boph Comp. 173 bopd

J. E. TYRA