

Map No. _____ Sec. 12 Twp. 29 R. 3


Well No. 1 Reed Farm

Empire Company

NORTH

WEST

EAST

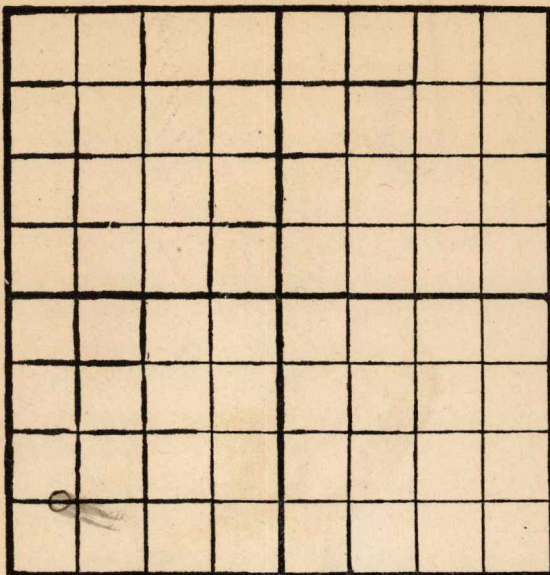

SOUTH

Location _____

Rig Up _____

Drilling Remarks:

Drilling Remarks:

RECORD

PRODUCTION

Cased _____ in. _____ ft.

1st 24 hrs. Nat. _____

Sand _____

1st 24 hrs. after shot _____

Gas _____

Gas _____ cu. ft.

Oil _____

Dry Hole _____


Total Depth _____

Abandoned _____

Map No. K12 Sec. 12 Twp. 29^s R. 3EWell No. Reed Farm
Continental Company

NORTH

WEST

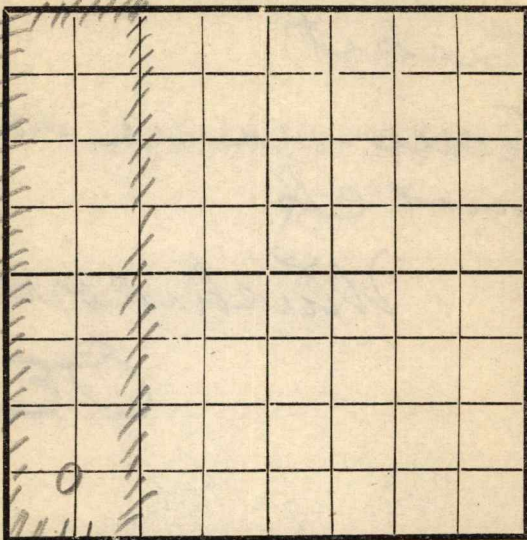

EAST

SOUTH

RECORD

Location -----

Cased ----- in. ----- Ft.

Rig Up -----

Sand -----

Drilling and remarks

Gas -----

Oil -----

Total Depth -----

PRODUCTION

1st 24 hrs. Nat. -----

1st 24 hrs. after shot -----

Gas ----- Cu. Ft.

Dry Hole -----

Abandoned -----


Date .

-----, 191----- Scout

Map No. K12 Sec. 12 Twp. 29^S R. 3^EWell No. 1 ReedEmpire Company

Contractor

NORTH

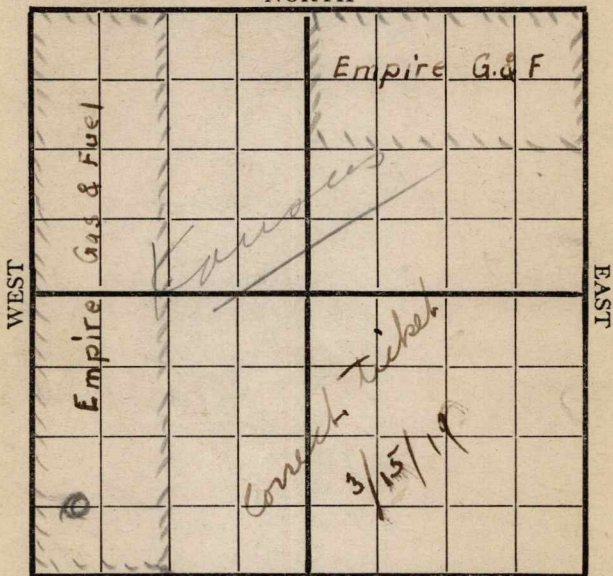1060 S

SOUTH

580 W

Location _____

Rig up _____

Drilling and Remarks:

fishing tools
@ 200'

RECORD

Cased _____ in., _____ ft.

Sand _____

Gas _____

Oil _____

Total Depth _____

PRODUCTION

1st 24 hrs. Nat. _____

1st 24 hrs. after shot _____

Gas _____ Cu. Ft.

Dry Hole _____

Abandoned _____

Date

2/25 1919 Pyle Scout

Map shows per
ticket.

Issue name does
not ck.

Which is correct?
OE

Tracing - H L

Moody L