
FORM 51 25M 8-50 WESTERN Barton KANSAS

Section 26 Township 16 Range 11W

Well No. #1 Kraft (B)

Company El Dorado

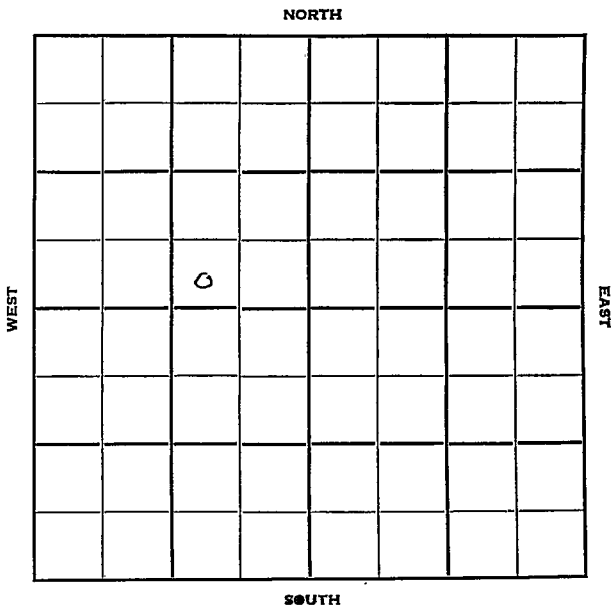

FORM 252-B
10M 8-51 TPCO.

Barton KANSAS

Sec. 26 Twp. 16 R. 11W

Well No. #1 Kraft (B) Farm

El Dorado Company

Sterling - Contr. Contractor

Kraft Prusa


_____ Ft. from N. Line

330' Ft. from S. Line

990' Ft. from E. Line

_____ Ft. from W. Line

SW SE NW

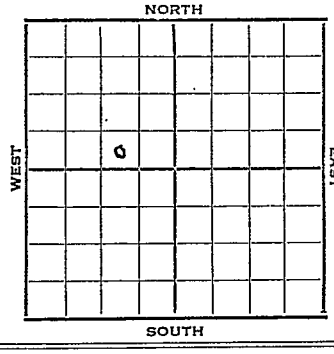

1951	Elev. 1914' REPORT
12/19	Location
1952 1/9	Spud 12-21-51 D & A - TD 3407' 8" @ 309 Heeb 2956' Tor. 2976' Br. lime 3059 Lans. 3072' Cong. 3360' Arb. 3384' TD 3407' D & A

ABANDONED

FORM 275 FOR SALE BY KANSAS BLUE PRINT CO.


County Barton State Kansas

Sec. 26 (Blk. Twp.) 16 (Sur. Rge.) 11W Map No.

Operator El Dorado

Well No. 1 Farm Kraft (B)

Elev. Location SW SE NW

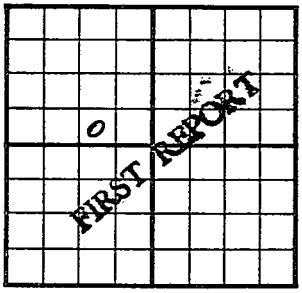

330 Ft. From S Line NW

990 Ft. From E Line Quarter

1st. Report DEC 19 1951

Completion

Remarks

Sterling - Contr.

Spudding Date

Drlg. Data Kraft Pruse

Location

J. E. TYRA

FORM 275 FOR SALE BY KANSAS BLUE PRINT CO.


County Barton State Kansas

Sec. 26 (Blk. Twp.) 16 (Sur. Rge.) 11W Map No.

Operator ElDorado Ref.

Well No. 1 Farm Kraft "B"

Elev. 1914 Location SW SE NW

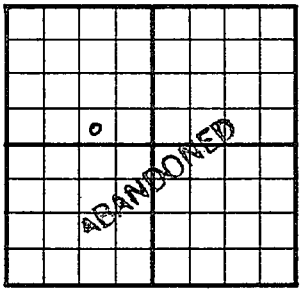

330 Ft. From S Line NW

990 Ft. From E Line Quarter

Ist. Report

Completion JAN 0 1952

Remarks Kraft-Prusa Pool
Sterling Drlg. - Contr.

Spudding Date 12-21-51

Drlg. Data D & A TD 3407

8" @ 309 Heeb. 2956 Tor. 2976

Br. lime 3059 Lans. 3072 Cong. 3360

Arb. 3384 TD 3407

D & A

J. E. TYRA