





Sec. 26 Twp. 16 R. 11W

Well No. #1 Homolka Farm

Derby Oil Company

Peel Bros. Contractor


\_\_\_\_\_ Ft. from N. Line

330 Ft. from S. Line

\_\_\_\_\_ Ft. from E. Line

330 Ft. from W. Line

SE  $\frac{1}{4}$  SW SW SE  
Shell - \$2500 DHM

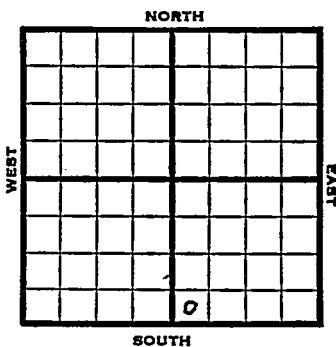

1952

Elev. 1923'

REPORT

11/5 Spud 11-3-52  
8" @ 318'

11/12 Heeb. 2962 Br Li 3064  
Lans. 3007  
Drig. 3152'

11/20 Arb. 3366-73' RTD 5" @ 3367  
CO 3373' B/51 gal 0 ~~plus~~ 1st hr.  
500 A

11/27 DD 3377 TD 19/3367-73, 1000A  
POP

12/4 NR

12/11  $\emptyset$  2503

12/18 P/188 BOPH

12/23 Spud 11-3-52

Oil well TD 3377' 8" @ 318  
Heeb 2962' Br. lime 3064' Lans. 3077  
Arb. 3366' TD 3373' 5" @ 3367  
CO to 3373 B/51 GO 500 A  
S/4 BOPH DD 3375 S/4 BOPH  
DD 3377 19/3367-73, 1000 A,  
S/17 BOPH S/12 BOPH P/188 BOPD  
Comp. 265 BOPD

**COMPLETED**



