

**GEOLOGICAL DEPARTMENT
SOUTHWESTERN GAS COMPANY**

INDEPENDENCE, KANSAS

Company **Sharpless et al**

Contractor **Sharpless**

Drilling Commenced **1925**

Drilling Completed **1925**


Initial Production **Shale gas**

Initial Rock Pressure

Location

Casing **6 1/2" 302'**

S. T. R. **24-28-16**
County **Wilson**
State **Kansas**
Lease and Well No. **Van Vicklo #2**

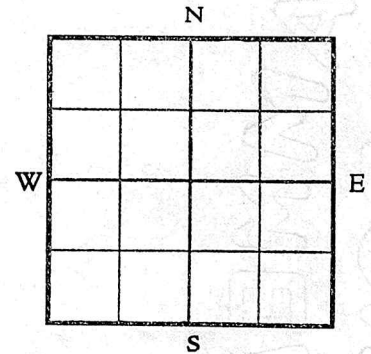

Driller's Record of Formations

13	soil	13
5	shells	18
37	shale	55
10	lime	65
40	shale	105
53	sand	158 4 bailers water
32	shale	190 per hour.
74	lime	264 gas
40	shale	304
71	lime	375 H.F.W. gas
101	shale	476
19	lime	495
92	shale	587
33	lime	620
24	shale & sand	644
26	lime Oswego	670 (20')
5	shale black	675 gas
10	lime	685 (5') 83 ?
4	shale black	689
2	shale white	691
15	shale blue	706
6	sand	712 gas
78	shale	790
72	sand	862