

GEOLOGICAL DEPARTMENT
SOUTHWESTERN GAS COMPANY
INDEPENDENCE, KANSAS

Company **Sharpless et al**

Contractor **Sharpless**

Drilling
Commenced

Drilling
Completed **1925**


Initial
Production **Small shale well**

Initial Rock
Pressure

Location **1200' N. and 200' E.**

Casing **10" 728'**

S. T. R. **24-28-16**
County **Wilson**
State **Kansas**
Lease and Well No. **Van Vickie #4**

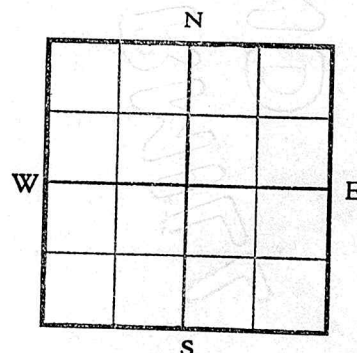

Driller's Record of Formations

7	soil	7	6	shale	880 oil
33	lime shell	40	50	sand 6 B. water	930
40	shale	95	35	shale	965
5	lime	100		gas sand at	1140
2	shale	102		water	1183 H.P.W.
4	lime	106		lime Miss.	1400
29	shale	135			
5	lime	140			
8	sand shale	145			
65	sand water	214			
36	shale	250			
60	lime	310			
55	shale	345			
27	lime	370			
11	shale	381			
59	lime gas	440			
15	shale black	455			
3	white shale	458			
8	lime	466			
14	shale black	480			
18	shale white	498			
19	lime	517			
8	shale	525			
10	lime	538			
25	shale	560			
42	shale	602			
28	shale	630			
42	lime brown	672			
22	shale	694			
21	lime Oswego	715			
4	shale black	719			
6	lime	725			
2	shale	727			
5	shale	732			
33	shale black	765			
27	shale black	792			
13	black ?	805			
30	shale black	835			
29	shale white	864			